

MISSISSIPPI DEPARTMENT OF NATURAL RESOURCES

Bureau of Land and Water Resources

Southport Mall

P.O. Box 10631

Jackson, Mississippi 39209

WATER WELL DRILLERS LOG

RANKIN
A 2001

April 1 1987 87 E.M. Bud Cresswell Rankin
Date well completed firm name county well located

LANDOWNER:	description of formations encountered	from	to
<u>Mid State Bass Club</u> <u>Pearl, Mo.</u> (mailing address)			
WELL LOCATION: sec. <u>25</u> T. <u>8</u> N R. <u>4</u> E W <u>on Hwy 43</u> (distance) miles (direction) of (nearest town)			
WELL PURPOSE: <u>Recreation</u> (home, irrigation, municipal, industrial)			
WELL COMPLETION DATA: (1) diameter (inches) <u>2</u> (2) total depth (feet) <u>33</u> (3) static water level (feet) <u>3</u> below top of ground. (4) casing <u>PVC</u> <u>23</u> (material) (depth) <u>2</u> if telescope see back. (size) (5) screen <u>10</u> <u>23</u> (length) (depth to top) <u>2</u> <u>PVC</u> (size) (material) (6) pump <u>1</u> <u>30</u> (HP) (yield gpm) (type power) (7) electric log <u>no</u> (yes or no) (organization running log) (8) how well bottom plugged <u>Sand shak</u>			
DRILLERS REMARKS:			


RECEIVED

APR 14 1987

Department of Natural Resources
Bureau of Land & Water Resources

If well telescopes please
sketch and show depths.

GROUND LEVEL

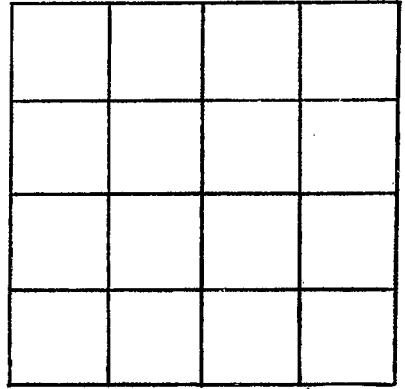

SECTION _____

Please indicate well location X.

ADDITIONAL INFORMATION

If more than one screen,
show locations of each on sketch.