

Rankin
B6
9-66

MISSISSIPPI BOARD OF WATER COMMISSIONERS

CODED

WATER WELL DRILLERS LOG

Date: 9-16, 1966, Driller: J P Thornton County Rankin
 (When well drilled) (Name) (Where well is located)

(1) Owner of Land: Sidney P. C. Holmes
 (Name)
Route 3, Box 72A Marton, Miss
 (Address)
E 1/2 of LOT 1, L 1255 20 acre
 (2) Location: 1/4, 1/4, Sec. 27 T. 8R S. 5
14 miles N.W., of Marton
 (distance) (direction) (Nearest Town)
 (3) Topography: X
 (Hilly) (Flat) (Level)
 (4) Purpose of Well: Domestic
 (Domestic Irrigation
 Municipal, Industrial, Other)


Description & Color of Materials Sand, Clay, Red Clay, Shell, etc.	Thick- ness Feet	Depth Feet
<u>Red clay</u>	<u>21</u>	<u>21</u>
<u>Blue Chalk</u>	<u>21</u>	<u>42</u>
<u>Black sand</u>	<u>13</u>	<u>55</u>
<u>Rock</u>	<u>3</u>	<u>58</u>
<u>Black Chalk</u>	<u>63</u>	<u>121</u>
<u>gray watersand</u>	<u>61</u>	<u>182</u>

Information upon completion of well:

(1) Diameter 2 inches.
 (2) Total Depth 182 feet.
 (3) Water Level 60 feet below top of ground.
 (4) Cased to 168, Size 2
 (5) Screen: Size 1 1/4 SS, Length 6 ft
 (6) Were any formations sealed against pollution?
no

CODED

If YES depth of formation _____
 Why _____
 Drillers Remarks: _____
 Yield in gpm: 8 gpm
 Size pump: 1 HP monact
 Type power: 220

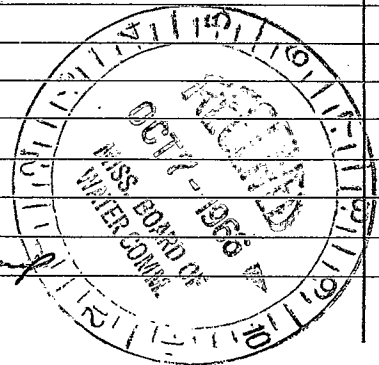

Retain this copy for your office files.

