

Rankin
B9
11-20-68

MISSISSIPPI
 BOARD OF WATER COMMISSIONERS
 416 North State Street
 Jackson, Mississippi 39201

CODED

WATER WELL DRILLERS LOG

11-20 1968 Forest Drilling Rankin
 date well completed firm name county well located

LANDOWNER: Joyd Derson
Judlow, Miss.
 (mailing address)

WELL LOCATION:
 sec 5 T 8 N R 5 E
8 miles W of Judlow
 (distance) (direction) (nearest town)

WELL PURPOSE: home
 (home, irrigation, municipal, industrial)

WELL COMPLETION DATA:

- (1) diameter (inches) 2"
- (2) total depth (feet) 304'
- (3) static water level (feet) 80' below above top of ground.
- (4) casing Galv 294'
 (material) (depth)
2" if telescope see back.
 (size)
- (5) screen 10' 294'
 (length) (depth to top)
2" Stainless Steel
 (size) (material)
- (6) pump 2 HP 12
 (HP) (yield gpm)
Alert
 (type power)
- (7) electric log NO
 (yes or no)
- (organization running log)
- (8) how well bottom plugged 2" B/W
halve

description of formations encountered	from	to
Brown clay	0	26
Blue clay + limestone	26	40
Sandy shale	40	46
Clay	46	81
Mud sand + clay	81	122
Clay	122	163
Clay + fine sand	163	225
Clay	225	245
fine sand + streaks clay	245	285
fine sand	285	304
Clay	304	327

CODED


JAN - 8 1969

DRILLERS REMARKS:

MISS. BD. OF
 WATER COMM.

If well telescopes please sketch and show depths.

GROUND LEVEL

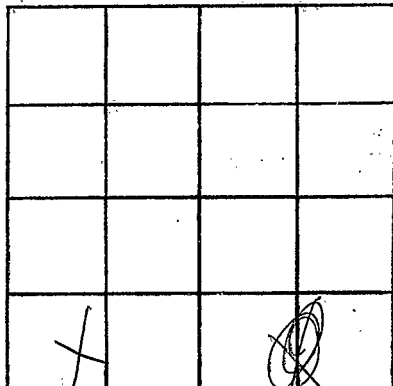

SECTION 5

Please indicate well location X.

ADDITIONAL INFORMATION

If more than one screen,
show locations of each on sketch.