

CODED
CODED

MISSISSIPPI
BOARD OF WATER COMMISSIONERS
416 North State Street
Jackson, Mississippi 39201.

WATER WELL DRILLERS LOG

Rankin
N B 11
6-20-69

6/20/69 1969 Forest Drilling Rankin
date well completed firm name county well located

| LANDOWNER: | description of formations encountered | from | to |
|--|---------------------------------------|------------|------------|
| (mailing address) | | | |
| <u>Coy Greenaker</u> | <u>Brown clay</u> | <u>0</u> | <u>25</u> |
| <u>Canton, Miss.</u> | <u>lime rock + shells</u> | <u>25</u> | <u>40</u> |
| | <u>Clay</u> | <u>40</u> | <u>81</u> |
| WELL LOCATION: | <u>Clay & other fine sand</u> | <u>81</u> | <u>163</u> |
| sec. <u>33</u> T. <u>9</u> N. R. <u>3</u> E. <u>5?</u> | <u>Clay</u> | <u>163</u> | <u>200</u> |
| (distance) miles (direction) of (nearest town) | <u>Fine sand</u> | <u>200</u> | <u>205</u> |
| WELL PURPOSE: <u>None</u> | <u>Clay</u> | <u>205</u> | <u>260</u> |
| (home, irrigation, municipal, industrial) | <u>Fine sand + other clay</u> | <u>260</u> | <u>327</u> |
| WELL COMPLETION DATA: | <u>Clay + other rock</u> | <u>327</u> | <u>409</u> |
| (1) diameter (inches) <u>2"</u> | <u>Shale</u> | <u>409</u> | <u>426</u> |
| (2) total depth (feet) <u>535'</u> | <u>Rock</u> | <u>426</u> | <u>429</u> |
| (3) static water level (feet) <u>183'</u> below top of ground. | <u>Shale & other rock</u> | <u>429</u> | <u>450</u> |
| (4) casing <u>Galv</u> (material), <u>525'</u> (depth) | <u>Shale</u> | <u>450</u> | <u>495</u> |
| <u>2"</u> (size) if telescope see back. | <u>Fine sand</u> | <u>495</u> | <u>534</u> |
| (5) screen <u>10'</u> (length), <u>525'</u> (depth to top) | | | |
| <u>2"</u> (size), <u>stainless steel</u> (material) | | | |
| (6) pump <u>1/2</u> (HP), (yield gpm) | | | |
| <u>6' elect</u> (type power) | | | |
| (7) electric log <u>no</u> (yes or no) | | | |
| (organization running log) | | | |
| (8) how well bottom plugged <u>2" Backwash Valve</u> | | | |
| DRILLERS REMARKS: | | | |


CODED

July 9 1969

MISS. DIV. OF
WATER RESOURCES

If well telescopes please
sketch and show depths.

GROUND LEVEL

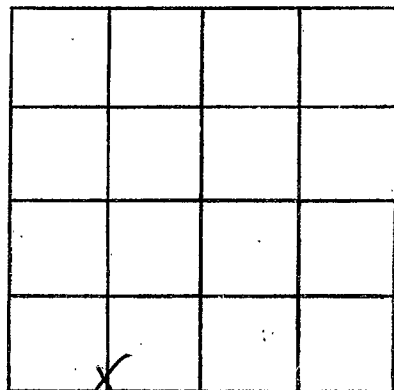

SECTION 23

Please indicate well location X.

ADDITIONAL INFORMATION

If more than one screen,
show locations of each on sketch.