

**RANKIN**  
**B12**  
**2-10-71**

MISSISSIPPI  
 BOARD OF WATER COMMISSIONERS  
 416 North State Street  
 Jackson, Mississippi 39201

**CODED**

**WATER WELL DRILLERS LOG**

*Rankin*  
*County*

2-10-1971  
 date well completed

Forest Drilling Ser.  
 firm name

county well located

LANDOWNER: *Ray Lawrence J*  
*Ludlow, Miss.*

description of formations encountered	from	to
Brown clay	0	25
Blue clay	25	40
Clay	40	81
Clay & streaks fine sand	81	198
fine sand & stks. Clay	198	245
fine sand	245	255
Clay	255	265
fine sand & stks. Clay	265	286
Clay & stks. fine sand	286	326
Clay	326	346
Clay & stks. rock	346	364
Clay	364	430
Clay & stks. rock	430	451
Clay	451	468
fine sand	468	559

(mailing address)

WELL LOCATION:

sec. 4 T. 8 N R. 5 E  
5 miles W of Ludlow  
 (distance) (direction) (nearest town)

WELL PURPOSE: *Family house*  
 (home, irrigation, municipal, industrial)

WELL COMPLETION DATA:

- (1) diameter (inches) 2"
- (2) total depth (feet) 556'
- (3) static water level (feet) 165 below top of ground.
- (4) casing Steel (material), 546' (depth)  
2" (size) if telescope see back.
- (5) screen 10' (length), 546' (depth to top)  
2" (size), Stainless Steel (material)
- (6) pump 3 (HP), 20 (yield gpm)  
Elec. (type power) (A11)
- (7) electric log NO (yes or no)  
 (organization running log)
- (8) how well bottom plugged 2"  
backwash valve


**CODED**

DRILLERS REMARKS:

APR 16 1971

If well telescopes please sketch and show depths.

GROUND LEVEL

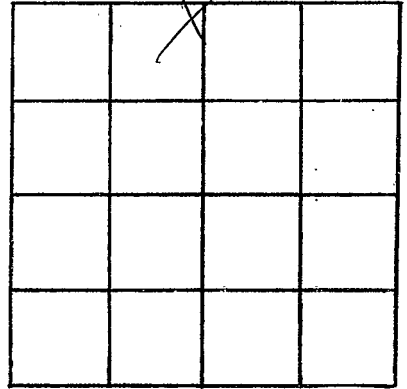

SECTION A

Please indicate well location X.

ADDITIONAL INFORMATION

If more than one screen,  
show locations of each on sketch.