

RANKIN
B13
8-10-71

MISSISSIPPI
 BOARD OF WATER COMMISSIONERS
 416 North State Street
 Jackson, Mississippi 39201

WATER WELL DRILLERS LOG

CODED

8-10 1971 Forest Drilling Ser. Rankin
 date well completed firm name county well located

LANDOWNER: <u>Clyde Fleming</u>	description of formations encountered	from	to
<u>Rt. 3, Morton, Miss</u>			
(mailing address)	<u>Brown clay</u>	<u>0</u>	<u>27</u>
	<u>Blue clay & lim rock</u>	<u>27</u>	<u>40</u>
	<u>Clay & sandy shale</u>	<u>40</u>	<u>61</u>
	<u>Soft clay & mucky sand</u>	<u>61</u>	<u>81</u>
	<u>fine sand & silty clay</u>	<u>81</u>	<u>102</u>
	<u>Clay & silty fine sand</u>	<u>102</u>	<u>184</u>
	<u>fine sand & silty clay</u>	<u>184</u>	<u>245</u>
	<u>fine sand</u>	<u>245</u>	<u>266</u>
WELL LOCATION: sec. <u>34</u> T <u>8</u> N R <u>5</u> E <u>12</u> miles <u>NW</u> of <u>Morton</u> (distance) (direction) (nearest town)	<u>fine sand & silty clay</u>	<u>266</u>	<u>306</u>
	<u>fine sand</u>	<u>306</u>	<u>333</u>
WELL PURPOSE: <u>Home</u> (home, irrigation, municipal, industrial)			

- WELL COMPLETION DATA:
- (1) diameter (inches) 2 1/2
 - (2) total depth (feet) 333'
 - (3) static water level (feet) 80 below above top of ground.
 - (4) casing Galv. 323
(material) (depth)
2" if telescope see back.
(size)
 - (5) screen 10' 323'
(length) (depth to top)
2" #008 - Stainless Steel
(size) (material)
 - (6) pump 3 1500 BPH
(HP) (yield gpm)
Electric
(type power)
 - (7) electric log no
(yes or no)
 - (organization running log)
 - (8) how well bottom plugged 2 1/2
Backwash Valve

CODED


OCT 22 1971

DRILLERS REMARKS:

MISS. BD. OF
 WATER COMMISSIONERS

If well telescopes please
sketch and show depths.

GROUND LEVEL

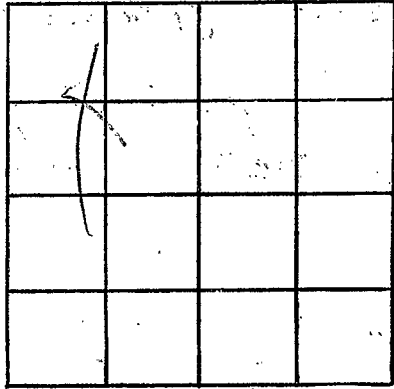

SECTION 34

Please indicate well location X.

ADDITIONAL INFORMATION

If more than one screen,
show locations of each on sketch.