

RANKIN
B 14
7-31-72

MISSISSIPPI
 BOARD OF WATER COMMISSIONERS
 416 North State Street
 Jackson, Mississippi 39201

CODED

WATER WELL DRILLERS LOG

7/31/72 19 1972 Forest Drilling Rankin
 date/well completed firm name county well located

LANDOWNER:
A. M. Dubois
Rt 2 - Lena, Miss
 (mailing address)

WELL LOCATION:
 sec 28 T S N R 5 E
7 miles N/E of Forest Hill
 (distance) (direction) (nearest town)

WELL PURPOSE: Home
 (home, irrigation, municipal, industrial)

- WELL COMPLETION DATA:
- (1) diameter (inches) 2"
 - (2) total depth (feet) 196
 - (3) static water level (feet) 90 below
 top of ground. above
 - (4) casing Galv. 186
 (material) (depth)
2"
 (size) if telescope see back.
 - (5) screen 10 186
 (length) (depth to top)
2" S/S Gauge
 (size) (material)
 - (6) pump 2 Aircorp 800 GPM
 (HP) (yield gpm)
Electric
 (type power)
 - (7) electric log No
 (yes or no)
- (organization running log)
- (8) how well bottom plugged Backwash
Blue

description of formations encountered	from	to
<u>107 over Clay</u>		<u>27</u>
<u>Blue Clay</u>		<u>35</u>
<u>Clay + gravel</u>		<u>61</u>
<u>Clay</u>		<u>81</u>
<u>Soft Clay</u>		<u>102</u>
<u>Clay</u>		<u>109</u>
<u>Clay + Gyp sand</u>		<u>122</u>
<u>Sand</u>		<u>143</u>
<u>2 sand + Clay</u>		<u>184</u>
<u>Thin sand</u>		<u>194</u>
<u>Soft Clay</u>		<u>198</u>
<u>Thin sand</u>		<u>204</u>

CODED


MIC - 0 1072

DRILLERS REMARKS:

MISS. BD. OF
 WATER COM.

If well telescopes please sketch and show depths.

GROUND LEVEL

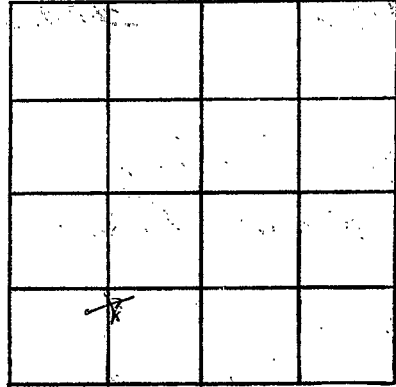

SECTION 28

Please indicate well location X.

ADDITIONAL INFORMATION

If more than one screen,
show locations of each on sketch.