

RANKIN
B 15
4-7-75

MISSISSIPPI
 BOARD OF WATER COMMISSIONERS
 416 North State Street
 Jackson, Mississippi 39201

CODED

WATER WELL DRILLERS LOG

April 7 1975 JOHN A DAVIS Rankin
 date well completed firm name county well located

LANDOWNER: MC-KINNEY description of formations encountered from to

SANHILL
 (mailing address)

WELL LOCATION:
 sec. 30 T 8 N R 5 E
 4 miles N of SANHILL
 (distance) (direction) (nearest town)

WELL PURPOSE:
 (home, irrigation, municipal, industrial)

WELL COMPLETION DATA:

- (1) diameter (inches) 2"
- (2) total depth (feet) 252
- (3) static water level (feet) 60 below top of ground.
- (4) casing 2.40 (material) PVC (depth) if telescope see back.
- (5) screen 12 (length) (depth to top) 2" 10 SLOT PVC (size) (material)
- (6) pump 3 H.P. 22 (HP) (yield gpm) Elect (type power)
- (7) electric log (yes or no)
- (organization running log)
- (8) how well bottom plugged PIN

description of formations encountered	from	to
light clay	0	30
fine sand	30	35
blue	35	120
sand streaks	120	160
sand fine	160	190
blue	190	210
sand good	210	252


CODED

RECEIVED
 APR - 9 1975

DRILLERS REMARKS:
 Good drilling

If well telescopes please sketch and show depths.

GROUND LEVEL

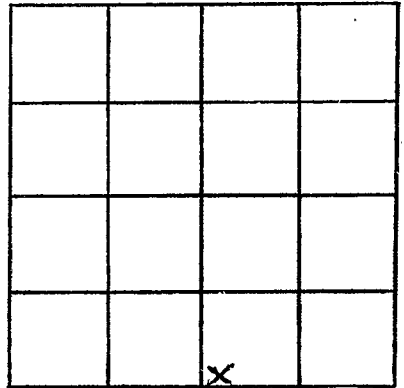

SECTION 30

Please indicate well location X.

ADDITIONAL INFORMATION

If more than one screen,
show locations of each on sketch.