

RANKIN

R 2000

6--80

MAY 19 80  
date well completed

MISSISSIPPI  
BOARD OF WATER COMMISSIONERS  
416 North State Street  
Jackson, Mississippi 39201

WATER WELL DRILLERS LOG

Thomas Sr  
firm name

RANKIN  
county well located

LANDOWNER: Lloyd Denson  
Ludlow, Ms.  
(mailing address)

WELL LOCATION:  
sec. 4 T 8 N R 5 E  
S W  
17 miles N of Paducah  
(distance) (direction) (nearest town)

WELL PURPOSE: Chicken Hatchery  
(home, irrigation, municipal, industrial)

WELL COMPLETION DATA:  
(1) diameter (inches) 2  
(2) total depth (feet) 290  
(3) static water level (feet) 66 below above top of ground.  
(4) casing PVC, 275 (material) (depth) 2 If telescope see back. (size)  
(5) screen 15, 275 (length) (depth to top) 2, 10 slot PVC (size) (material)  
(6) pump 2 HP Old Air Comp 20 (HP) (y/field gpm) 8 hp (type power)  
(7) electric log NO (yes or no)  
(8) how well bottom plugged Solid


description of formations encountered	from	to
Gumbo	0	10
CHALK	10	30
Blue Chalk	30	37
Rock & shell	37	42
Dirty Green Sand	42	55
BLACK D.V	55	83
SAND	83	117
Fine Sand & Grey Chalk	117	173
Coar SAND	173	290

DRILLERS REMARKS:

DEPT. OF NATURAL RESOURCES  
BUREAU OF LAND & WATER RESOURCES  
JUL 16 1980  
RECEIVED

If well telescopes please sketch and show depths.

GROUND LEVEL

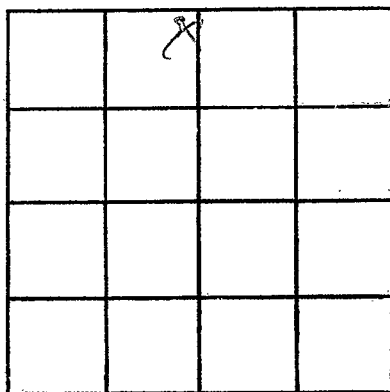

SECTION 4

Please indicate well location X.

ADDITIONAL INFORMATION

If more than one screen,  
show locations of each on sketch.