


ELOG # 137
 C. J. MGS
 CODED

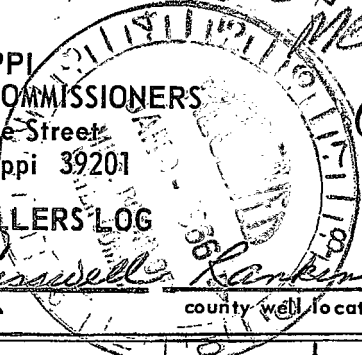

MISSISSIPPI
 BOARD OF WATER COMMISSIONERS
 416 North State Street
 Jackson, Mississippi 39201

WATER WELL DRILLERS LOG

Rankin
C-11
6-66
Elec. Log

June 21 1966 Creel of Cresswell Rankin
 date well completed firm name county well located

LANDOWNER:
Jackson Fire Department
Jackson Miss.
 (mailing address)

description of formations encountered	from	to
Clay-blue		
Ysop Clay	0	230
Grey shale streaks		
of sand	230	320
Shale	320	428
sand fine	428	468
shale hard	468	548
sand-gold	548	600

WELL LOCATION:
 sec 29 T 7 N R 3 E
4 miles West of Fanner
 (distance) (direction) (nearest town)

WELL PURPOSE: public
 (home, irrigation, municipal, industrial)

WELL COMPLETION DATA:

(1) diameter (inches) 4 x 2 1/2

(2) total depth (feet) 600

(3) static water level (feet) 8 1/2 below above top of ground.

(4) casing steel, 267,
 (material) (depth)
4 if telescope see back.
 (size)

(5) screen 40, 560
 (length) (depth to top)
2 1/2, stainless
 (size) (material) (R)

(6) pump 2, 35
 (HP) (yield gpm)
220-
 (type power)

(7) electric log yes
 (yes or no)
M. S. D. S.
 (organization running log)

(8) how well bottom plugged _____

DRILLERS REMARKS:

