

Rankin  
 C23  
 4-19-67  
 M.G.S.  
 4/19 1967

MISSISSIPPI  
 BOARD OF WATER COMMISSIONERS  
 416 North State Street  
 Jackson, Mississippi 39201

Copy  
**CODED**  
**CODED**  
 Rankin

WATER WELL DRILLERS LOG

date well completed 4/19 1967 firm name Forest Drilling county well located Rankin

LANDOWNER: Farris  
Water Assoc.  
Farris, Miss.  
 (mailing address)

description of formations encountered	depth	
	from	to
Clay + sand	0	125
Blue clay	125	160
Blue shale	160	346
Shale + lime	346	389
Shale	389	420
Shale + shaly rock	420	490
Rock	490	491
Shale	491	681
Silt + shale	681	714
Blue shale	714	834
Rock	834	840
Shale + shaly rock	840	861
Shale + silt	861	882
Shale + shaly rock	882	960
Shale + shaly rock + silt	960	1030
Shale + shaly sand	1030	1050
Sand	1050	1090
Shale + silt	1090	1130
Fine sand	1130	1145
Med. sand	1145	1196
Shale -	1196	1206

WELL LOCATION:  
 sec. 26 T. 7 N. R. 3 E. S. 1  
Farris, Miss.  
 (distance) miles (direction) of (nearest town)

WELL PURPOSE: Domestic  
 (home, irrigation, municipal, industrial)

WELL COMPLETION DATA:  
 (1) diameter (inches) 8"  
 (2) total depth (feet) 1202'  
 (3) static water level (feet) 320 below above top of ground.  
 (4) casing Steel, 1135'  
 (material) (depth)  
8" if telescope see back.  
 (size)  
 (5) screen 45' 1157'  
 (length) (depth to top)  
6" sterilized steel  
 (size) (material)  
 (6) pump 30 126  
 (HP) (yield gpm)  
Elect  
 (type power)  
 (7) electric log yes  
 (yes or no)  
Miss. Geological  
 (organization running log)  
 (8) how well bottom plugged 6" x 2"  
Gravel wash blue

DRILLERS REMARKS:


APR 17 1969

MISS. BD. OF  
 WATER COMM.

(X)

If well telescopes please sketch and show depths.

GROUND LEVEL

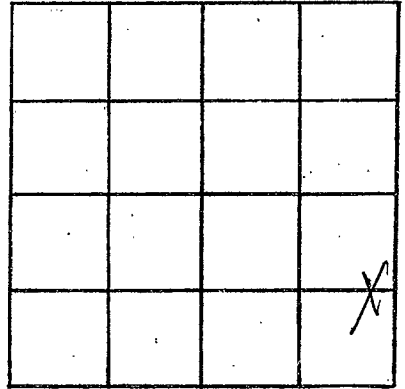

SECTION 26

Please indicate well location X.

ADDITIONAL INFORMATION

If more than one screen,  
show locations of each on sketch.