

C 28

CODED

2-24-66

WATER WELL DRILLERS LOG

Date: 2/24, 1966, Driller: Forest Drilling County Rankin
(Name)


(1) Owner of Land: R. O. Burnett
(Name)
Rt 3 Box 124 Brandon, Miss
(Address)
(2) Location: 1/4, 1/4, Sec 32 T N R 3E
8 miles North, of Brandon
(distance) (direction) (Nearest Town)
(3) Topography: ✓
(Hilly) (Flat) (Level)
(4) Purpose of Well: Home
(Domestic Irrigation
Municipal, Industrial, Other)

Description & Color of Materials Sand, Clay, Red Clay, Shell, etc.	Thick- ness Feet	Depth Feet
Red Clay		12
Clay + Red Sand		28
Blue Clay		202
Spalls		287
Shells + Sh. lock		297
Sandy Shell		312
Sand + Shell		321
Sandy Spalls + Sh. lock		331
Fine sand + Clay		341
Clay		361
Mucky Clay + Sand		465
Clay + Shells + Fine sand		472
Fine sand		475
Fine sand + Sh. clay		493
Fine sand		506
Clay + Sand		515

Information upon completion of well:

(1) Diameter 2 inches.
(2) Total Depth 515 feet.
(3) Water Level 112 feet below top of ground.
(4) Cased to 504, Size 2"
(5) Screen: Size 2", Length 11ft.
(6) Were any formations sealed against pollution?
✓ yes, no.

CODED

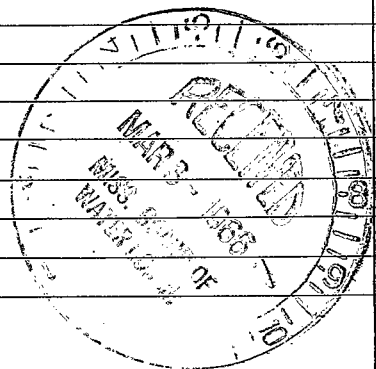

If YES depth of formation _____
Why _____
Drillers Remarks: _____

(Use Back Side)

Well No.

