

RANKIN MISSISSIPPI BOARD OF WATER COMMISSIONERS

CODED

~~D-4~~ C31

8-6-62



Date: Aug 6, 1962 Driller: McKay
(Name)

County Rankin

(1) Owner of Land: Clyde Calhoun
(Name)

Lochum Springs, Miss
(Address)

(2) Location: 1/4, 1/4, Sec. 1 T R 3

1 miles W, of Lochum Springs
(distance) (direction) (Nearest Town)

(3) Topography: 2
(Hilly) (Flat) (Level)

(4) Purpose of Well: Home
(Domestic Irrigation, Municipal, Industrial, Other)

Description & Color of Materials Sand, Clay, Red Clay, Shell, etc.	Thick- ness Feet	Depth Feet
<u>Yellow Clay</u>	<u>0</u>	<u>21</u>
<u>yellow sand</u>	<u>21</u>	<u>23</u>
<u>Blue Clay</u>	<u>23</u>	<u>42</u>
<u>Blue Clay</u>	<u>42</u>	<u>63</u>
<u>Blue Clay</u>	<u>63</u>	<u>147</u>
<u>Sandy Clay</u>	<u>147</u>	<u>189</u>
<u>Sandy Clay</u>	<u>189</u>	<u>252</u>
<u>Fine Sand</u>	<u>252</u>	<u>315</u>
<u>Med Sand</u>	<u>315</u>	<u>346</u>

Set Screen at 347 ft

3/4 H Jet Pump!

Information upon completion of well:

(1) Diameter 2 inches.

(2) Total Depth 346 feet.

(3) Water Level 75 feet below top of ground.

(4) Cased to _____, Size _____

(5) Screen: Size 007 STAINLESS, Length 10 ft


(6) Were any formations sealed against pollution?
yes, no,

If YES depth of formation _____

Why _____

Drillers Remarks: _____

CODED

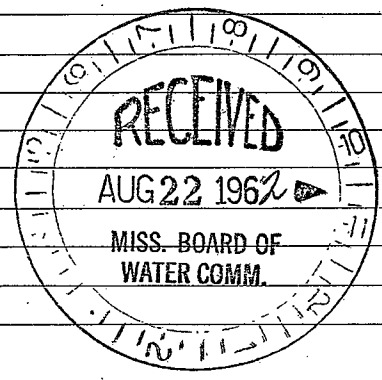

(Use Back Side)

Well No.

