

MISSISSIPPI  
 BOARD OF WATER COMMISSIONERS  
 416 North State Street  
 Jackson, Mississippi 39201

CODED

WATER WELL DRILLERS LOG

RANKIN  
 C34  
 4-80  
 Elog #495

April 1980  
 date well completed Herndon Well & Supply, Inc. firm name Rankin county well located

LANDOWNER:		description of formations encountered	from	to
Inc.	Route 3			
Brandon, MS 39042 (mailing address)		top soil	0	3
WELL LOCATION:		Sandy Clay	3	60
sec. 35 T. 7 N. R. 3 E W		Sand, gravel stks clay	60	70
4 miles north of Brandon (distance) (direction) (nearest town)		Yazoo clay	70	320
WELL PURPOSE: Community (home, irrigation, municipal, industrial)		Sand w/ shells	320	360
WELL COMPLETION DATA:		Clay w/ sand stks	360	660
(1) diameter (inches)	10 by 6	Hard Shale	660	800
(2) total depth (feet)	1190	Shale	800	900
(3) static water level (feet)	230 below top of ground.	Sand w/clay stks	900	1020
(4) casing (material)	Steel 1125 (depth)	Clay w/sand stks.	1020	1070
	10" (size) if telescope see back.	Sand	1070	1100
(5) screen (length)	61 1064 (depth to top)	Sand w/clay stks.	1100	1200
	6" Ribbed .025 (size) (material)	Clay	1200	1210
(6) pump (HP)	40 300 (yield gpm)	Hard Rock	1210	1215
	Elec. (type power)	Clay	1215	1265
(7) electric log	yes (yes or no)			
	MS GS (organization running log)			
(8) how well bottom plugged	BWV			
DRILLERS REMARKS:				

DEPT. OF NATURAL RESOURCES  
 BUREAU OF LAND & WATER RESOURCES  
 MAY 20 1980  
 RECEIVED

⊗

NE/4

SE/4

SW/4


If well telescopes please  
sketch and show depths.

GROUND LEVEL

10 casing

106' →

6" Screen →

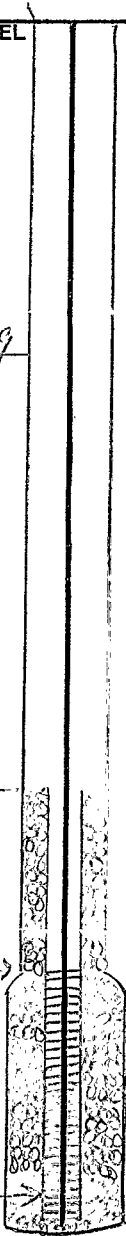

		X	

SECTION 35

Please indicate well location X.

ADDITIONAL INFORMATION

---

---

If more than one screen,  
show locations of each on sketch.