


2-A

C-42

If well telescopes please sketch and show depths.

GROUND LEVEL	
0 - 30	Red sand
31 - 225	Clay
	Clay bank
	Hard
15 - 225	
Total - 3375	
House	
Boring	
o	o
o	o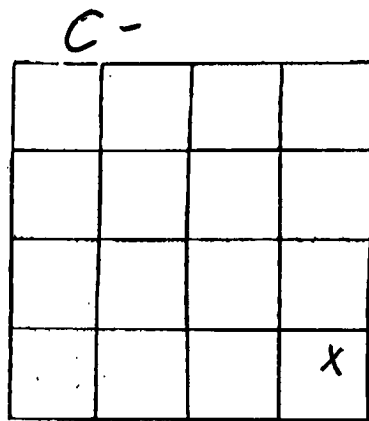
SECTION _____

Please indicate well location X.

Pump Capacity (GPM)	No. of Stages	Soring Depth	FT.
PUMP TEST			
Well yielded _____ GPM with			
a drawdown of _____ ft.			
after _____ hours of pumping			

LOG DATA

TYPE OF LOG RUN (Circle One): No Log Run, Electric, Gamma Ray, Density, Sonic, Neutron, Other (Describe) _____

Name of Organization Running Log _____

GEOLOGIC DATA (Office Use Only)

Surface Elev.	Geologic Unit	Unit Thickness	Depth to Top
Subs. SWL	Date	Analysis	Aquifer Test

Driller's Remarks

If more than one screen, show location of each on sketch.