

RANKIN
D8

7-27-60

WATER WELL DRILLERS LOG

D 300
CODED

Date: JULY 27, 1960, Driller: R. G. McNEECE County: RANKIN
(Name)

(1) Owner of Land: GEORGE A. MASSEY
(Name)
GOSHEN SPRINGS, MISS.
(Address)

(2) Location: NW 1/4, NW 1/4, Sec. 5 T. 7 R. 4
17 miles N of BRANDON
(distance) (direction) (Nearest Town)

(3) Topography: HILLY
(Hilly) (Flat) (Level)

(4) Purpose of Well: DOMESTIC
(Domestic Irrigation
Municipal, Industrial, Other)

Description & Color of Materials Sand, Clay, Red Clay, Shell, etc.	Thick- ness Feet	Depth Feet
RED CLAY	6	0
WHITE SHALE	98	6
GREY SHALE	196	34
ROCK	3	230
LIGNITE, SAND + SHALE	22	233
BLACK SHALE	24	255
GREY SHALE	39	279
SHALE + FINE SAND	42	318
WATER SAND	42	360
		402

Information upon completion of well:

(1) Diameter 4 inches.

(2) Total Depth 402 feet.


(3) Water Level 134 feet below top of ground.

(4) Cased to 300', Size 4"
300' - 382' - 2"

(5) Screen: Size 2, Length 20'

(6) Were any formations sealed against pollution?
no

CODED

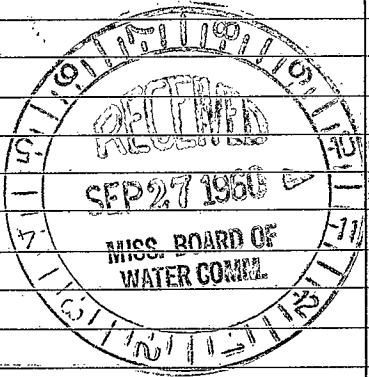

If YES depth of formation _____

Why _____

Drillers Remarks: _____

Well No. 3

(Use Back Side)

