

Rankin

D10

11-66

E-109

MISSISSIPPI
 BOARD OF WATER COMMISSIONERS
 416 North State Street
 Jackson, Mississippi 39201

CODED

WATER WELL DRILLERS LOG

11-15 1966 date well completed
 State Well Dr. Co. Rankin firm name
 county well located

LANDOWNER: B. F. Little
Tannin, Miss.
 (mailing address)

description of formations encountered	depth	
	from	to
Sand	0	20
Blue clay	20	280
" clay + sand	280	390
medium sand	390	420
Coarse sand	420	460
Medium sand	460	500
Clay	500	505

WELL LOCATION: SW 1/4 SE
 sec. 32 T. 7 N. R. 4 E
S W
5 miles SW of Tannin
 (distance) (direction) (nearest town)

WELL PURPOSE: Home
 (home, irrigation, municipal, industrial)

WELL COMPLETION DATA:

- (1) diameter (inches) 4 x 2
- (2) total depth (feet) 505
- (3) static water level (feet) 100 below top of ground. above
- (4) casing C.I., 270
 (material) (depth)
4"
 (size) If telescope see back.
- (5) screen 10, 450
 (length) (depth to top)
2", S.S.
 (size) (material)
- (6) pump 1 1/2 sub., 20
 (HP) (yield gpm)
Elec.
 (type power)
- (7) electric log yes
 (yes or no)
Miss. Geo. Surv.
 (organization running log)
- (8) how well bottom plugged _____


CODED

JUL - 8 1968
 MISS. BOARD OF
 WATER COMMISSIONERS

DRILLERS REMARKS:

If well telescopes please sketch and show depths.

GROUND LEVEL

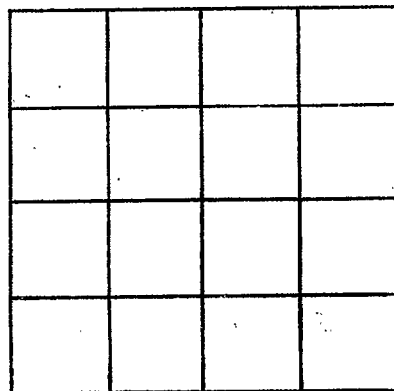

SECTION _____

Please indicate well location X.

ADDITIONAL INFORMATION

If more than one screen,
show locations of each on sketch.