

MISSISSIPPI DEPARTMENT OF NATURAL RESOURCES

Bureau of Land and Water Resources

Southport Mall

P.O. Box 10631

CODED

Jackson, Mississippi 39209

WATER WELL DRILLERS LOG

Rankin
D 15
10-7-81

Griner Drilling Service, Inc.

Rankin

10-7-81 date well completed

Griner Drilling Service, Inc. firm name

Rankin county well located

LANDOWNER:	description of formations encountered	from	to
Pennzoil Producing Co. P.O. Box 6088 Shreveport, La 71106 (mailing address)	Chalk	0	231
WELL LOCATION: 1500'S & 1500'E sec. 16 T 7 N R 4 E of No. 1 of 84 of 5400 acres of NW/4 of S.W. 1/4 of 3636 acres of NW/4 of	Sand, shell mixed	231	252
WELL PURPOSE: Oil field supply (home, irrigation, municipal, industrial)	streaked	252	357
WELL COMPLETION DATA:	chalk, sand	357	378
(1) diameter (inches) 3"	sand	378	462
(2) total depth (feet) 609'	Sand, chalk, sand	462	483
(3) static water level (feet) 170' (below top of ground)	sand	483	567
(4) casing Steel 588' (material), (depth)	Sand, chalk	567	588
3" (size) if telescope see back.	chalk	588	609
(5) screen 42' 546' (length), (depth to top)			
3" perforated (size), (material)			
(6) pump — 70 (HP), (yield gpm)			
AC (type power)			
(7) electric log — (yes or no)			
(organization running log)			
(8) how well bottom plugged Orange peel			
DRILLERS REMARKS:			

CODED


DEPT. OF NATURAL RESOURCES
BUREAU OF LAND & WATER RESOURCES

OCT 20 1981

RECEIVED

If well telescopes please
sketch and show depths.

GROUND LEVEL

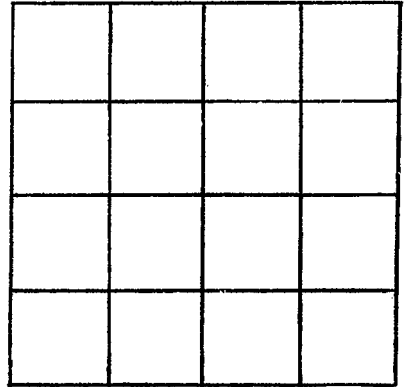

SECTION _____

Please indicate well location X.

ADDITIONAL INFORMATION

If more than one screen,
show locations of each on sketch.