

RANKIN
D21
8-7-72

MISSISSIPPI
BOARD OF WATER COMMISSIONERS
416 North State Street
Jackson, Mississippi 39201

CODED

WATER WELL DRILLERS LOG

8/7/72 19 Forest Drilling Rankin
date well completed firm name county well located

LANDOWNER:	description of formations encountered	from	to
<u>C. H. Wright</u> <u>Goshen, Spring Mt.</u> (mailing address)	<u>Red Clay + Sand</u>	<u>0</u>	<u>16</u>
	<u>Clay</u>		<u>20</u>
	<u>(same)</u>		<u>204</u>
	<u>Shale + 5th Lock</u>		<u>225</u>
	<u>Shale</u>		<u>245</u>
	<u>Shale + 5th Lock</u>		<u>257</u>
	<u>Sandy Shell</u>		<u>278</u>
	<u>Clay</u>		<u>286</u>
	<u>Shale</u>		<u>320</u>
	<u>Clay + 5th silt Sand</u>		<u>335</u>
	<u>Fine sand</u>		<u>342</u>
	<u>3rd + F Sand</u>		<u>347</u>
	<u>Clay + 5th F. sand</u>		<u>367</u>
	<u>Salt Clay</u>		<u>388</u>
	<u>Clay + 6th Sand</u>		<u>409</u>
	<u>F. Sand + Clay</u>		<u>450</u>
	<u>Clay</u>		<u>491</u>
	<u>Clay + 5th</u>		<u>490</u>
	<u>Fine sand</u>		<u>490</u>
	<u>Clay</u>		<u>636</u>
	<u>Shale + 5th Lock</u>		<u>656</u>
	<u>Shale</u>		<u>715</u>
	<u>Shale + 5th Lock</u>		<u>735</u>
	<u>3rd</u>		<u>775</u>
	<u>3rd Shale</u>		<u>828</u>
	<u>Fine sand</u>		<u>840</u>

CODED

AUG - 9 1972

MISS. DEP. OF
AGRICULTURE
AND FORESTRY

WELL LOCATION:
sec. 5 T. 7 N. R. 4 E.
near Selphore Town at end
miles of (distance) (direction) (nearest town)


WELL PURPOSE: Home
(home, irrigation, municipal, industrial)

- WELL COMPLETION DATA:
- (1) diameter (inches) 2"
 - (2) total depth (feet) 846
 - (3) static water level (feet) 220 below top of ground.
 - (4) casing 2" 831 ft.
(material) (depth)
 - 2" if telescope see back.
(size)
 - (5) screen 15 831 ft.
(length) (depth to top)
 - 2" Galv.
(size) (material)
 - (6) pump 5 HP 200 GPM
(HP) (yield gpm)
 - elect
(type power)
 - (7) electric log No
(yes or no)
 - (organization running log)
 - (8) how well bottom plugged plus

DRILLERS REMARKS:

If well telescopes please sketch and show depths.

GROUND LEVEL

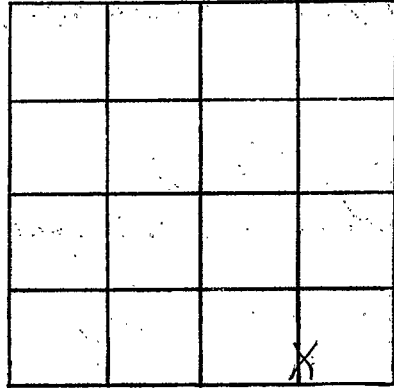

SECTION 5

Please indicate well location X.

ADDITIONAL INFORMATION

If more than one screen, show locations of each on sketch.