

RANKIN  
D-25  
1-12-81

MISSISSIPPI  
BOARD OF WATER COMMISSIONERS  
416 North State Street  
Jackson, Mississippi 39201

CODED

WATER WELL DRILLERS LOG

JAN 12 1981 date well completed  
E.M. "Bud" CRESSWELL firm name  
RANKIN county well located

LANDOWNER:  
Shell Oil Co.  
Haugberg No. 3  
New Orleans, LA.  
(mailing address)

description of formations encountered	from	to
Yellow clay	0	35
Blue clay	35	320
sandy shale	320	490
SAND	490	530

WELL LOCATION:  
sec 24 T 7 N R 4 E  
3 miles SE of Pisgah  
(distance) (direction) (nearest town)

WELL PURPOSE: Industrial  
(home, irrigation, municipal, industrial)

- WELL COMPLETION DATA:
- (1) diameter (inches) 4
  - (2) total depth (feet) 530
  - (3) static water level (feet) 120 below top of ground.
  - (4) casing Steel 570  
(material) (depth)  
4 (size) If telescope see back.
  - (5) screen 20 570  
(length) (depth to top)  
4 Stainless  
(size) (material)
  - (6) pump air 85  
(HP) (yield gpm)  
0 (type power)
  - (7) electric log No  
(yes or no)
- (organization running log)

(8) how well bottom plugged  
Steel plug

DRILLERS REMARKS:


DEPT. OF NATURAL RESOURCES  
BUREAU OF LAND & WATER RESOURCES

JAN 22 1981

RECEIVED

If well telescopes please sketch and show depths.

GROUND LEVEL

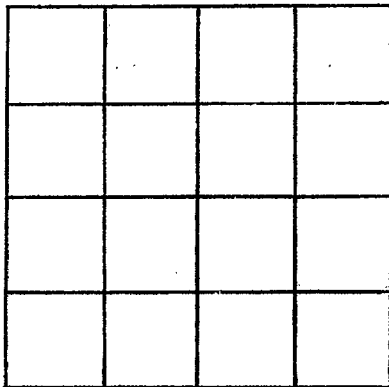

SECTION \_\_\_\_\_

Please indicate well location X.

ADDITIONAL INFORMATION

If more than one screen, show locations of each on sketch.