

MISSISSIPPI DEPARTMENT OF NATURAL RESOURCES

Bureau of Land and Water Resources

Southport Mall

P.O. Box 10631

Jackson, Mississippi 39209

CODED

WATER WELL DRILLERS LOG

Griner Drilling Service, Inc.

Rankin

RANKIN  
D26  
11-25-81

11-25-81 date well completed

Griner Drilling Service, Inc. firm name

Rankin county well located

LANDOWNER:	description of formations encountered	from	to
Shell Oil Company P.O. Box 61555 New Orleans, La (mailing address) 71060	chalk	0	210
WELL LOCATION: 2850' S 41500' E sec. 25 T 70 N R. 4 E of No 4 Hauberg South Disposal Field (distance) miles (direction) (nearest town)	sand & shell	210	252
WELL PURPOSE: Oil Field (home, irrigation, municipal supply)	chalk	252	357
WELL COMPLETION DATA:	streaked	357	420
(1) diameter (inches) 4"	chalk - 10' sand	420	441
(2) total depth (feet) 546'	sand	441	525
(3) static water level (feet) 90' below top of ground.	chalk	525	546
(4) casing steel 525' (material) (depth) 4" (size) if telescope see back.			
(5) screen 42' 483' (length) (depth to top) 4" perforated (size) (material)			
(6) pump AC 70 (HP) (yield gpm) (type power)			
(7) electric log (yes or no)			
(8) how well bottom plugged peel orange			
DRILLERS REMARKS:			

CODED


DEPT. OF NATURAL RESOURCES  
BUREAU OF LAND & WATER RESOURCES

JAN 21 1982

RECEIVED

If well telescopes please sketch and show depths.

GROUND LEVEL

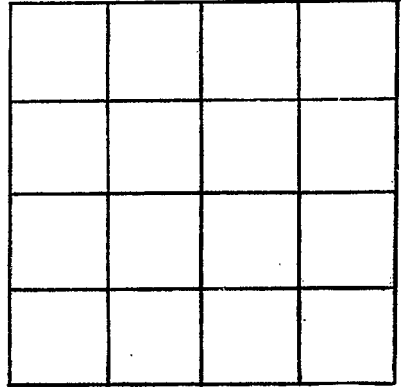

SECTION \_\_\_\_\_

Please indicate well location X.

ADDITIONAL INFORMATION

If more than one screen, show locations of each on sketch.