

MISSISSIPPI DEPARTMENT OF NATURAL RESOURCES

Bureau of Land and Water Resources

Southport Mall

P.O. Box 10631

Jackson, Mississippi 39209

WATER WELL DRILLERS LOG

CODED

RANKIN
D28
8-2-82

Aug. 2 1982 date well completed
S. E. M. "Bud" CRESSWELL firm name
Rankin county well located

LANDOWNER:	description of formations encountered	from	to
Shell Oil Company New Orleans, La. (mailing address)			

WELL LOCATION:
sec. 23 T 7 N R 4 E
6 miles EAST of JACKSON
(distance) (direction) (nearest town)

CODED

WELL PURPOSE: Home
(home, irrigation, municipal, industrial)

- WELL COMPLETION DATA:
- (1) diameter (inches) 3
 - (2) total depth (feet) 500
 - (3) static water level (feet) 120 below top of ground.
 - (4) casing 4 (material), 460 (depth)
 - 3 (size) if telescope see back.
 - (5) screen 40 (length), 460 (depth to top)
3 (size), STAINLESS (material)
 - (6) pump Air Comp. (HP), (yield gpm)
 - (type power)
 - (7) electric log No (yes or no)
 - (organization running log)

DEPT. OF NATURAL RESOURCES
BUREAU OF LAND & WATER RESOURCES

AUG 31 1982


RECEIVED

(8) how well bottom plugged
back wash valve

DRILLERS REMARKS:

If well telescopes please
sketch and show depths.

GROUND LEVEL

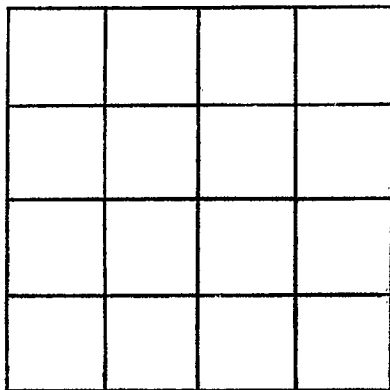

SECTION _____

Please indicate well location X.

ADDITIONAL INFORMATION

If more than one screen,
show locations of each on sketch.