

MISSISSIPPI DEPARTMENT OF NATURAL RESOURCES

Bureau of Land and Water Resources

Southport Mall

P.O. Box 10631

CODED

Jackson, Mississippi 39209

WATER WELL DRILLERS LOG

RANKIN CO.
D30
00/00/1984
GW02530

02

1984 GRIMER DRILLING SERVICE RANKIN
date well completed firm name county well located

LANDOWNER: SHELL WESTERN	description of formations encountered	from	to
E+T-CARBON DIOXIDE PLANT			
NEW ORLEANS, LA. (mailing address)	TOP SOIL	0	2
	CLAY	2	230
	SAND	230	272
	CLAY	272	328
	SAND	328	382
	CLAY	382	412
	SAND	412	450
	CLAY & SAND STREAKS	450	508
	SAND	508	560

WELL LOCATION: NE 1/4 S 1/4 NE 1/4
sec. 36 T. 2 N. R. 4 E

WELL PURPOSE: (home, irrigation, municipal, (Industrial))

WELL COMPLETION DATA:

- (1) diameter (inches) 6 7/8
- (2) total depth (feet) 560 ft.
- (3) static water level (feet) 156 below top of ground.
- (4) casing (material) Steel, (depth) 504 ft.
6 7/8" (size) if telescope see back.
- (5) screen (length) 30 @ 530 (depth to top)
4 (size) (1008) 30x5.S. (material)
- (6) pump (HP) 15 (yield gpm) 100
Ebot. (440 V.) (type power)
- (7) electric log (yes or no) Yes
Miss Geol Survey (organization running log)
- (8) how well bottom plugged BACK WAS
WAVE & 5th stringer

RECEIVED

FEB 8 1985


DRILLERS REMARKS:

Department of Natural Resources
Bureau of Land & Water Resources

⊗

If well telescopes please
sketch and show depths.

GROUND LEVEL

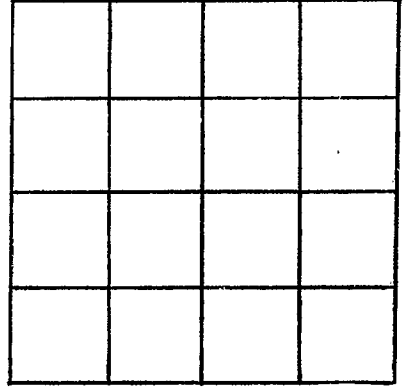

SECTION _____

Please indicate well location X.

ADDITIONAL INFORMATION

If more than one screen,
show locations of each on sketch.