

MISSISSIPPI DEPARTMENT OF ENVIRONMENTAL QUALITY

Office of Land and Water Resources

P. O. Box 10631
Jackson, MS 39289-0631
WATER WELL DRILLERS LOG

COUNTY WELL LOCATED Rankin	
WELL NUMBER no1	CODED D 341
P.R.I. Corp. 245	
DATE WELL COMPLETED 10-29-94	

PERMIT NUMBER 0-184
NAME OF DRILLING FIRM Griner Drilling

NAME & MAILING ADDRESS OF LANDOWNER Energy Drilling CO. P.O. BOX 905 Natchez MS 39121		
WELL LOCATION: SEC	TOWNSHIP	RANGE
24	7	4
	N	E
	S	W
DISTANCE	DIRECTION	NEAREST TOWN
3 Miles	E	of Sandhill
OTHER LANDMARK 10 miles N of Hwy 80 on 43		
WELL PURPOSE: Home, Irrigation, Municipal, Industrial, Fish Pond, etc. Oilfield Rig Supply		

PUMP DATA		
PUMP TYPE (Circle One): Submersible, Turbine, Jet, Flowing Well, Other (Describe) _____		
POWER TYPE (Circle One): Electric, Tractor, Diesel, Gasoline, Butane, Other (Describe) _____ H/P _____		
Pump Capacity (GPM) AWT	No. of Stages	Setting Depth FT.
PUMP TEST		
Well yielded 60 GPM with a drawdown of _____ ft. after _____ hours of pumping		

WELL DATA		
Well Depth 530'	Casing Diameter (In.) 3"	Casing Length (Ft.) 490
Type of Casing steel	Hole Depth 600'	Depth to Static Water Level 200'
TYPE OF COMPLETION: (Circle One or More): Gravel Packed, Underreamed, Telescoped, Natural Development , Open Hole, Other		

LOG DATA	
TYPE OF LOG RUN (Circle One): Electric, Gamma Ray, Density, Sonic, Neutron, Other (Describe) _____ No Log Run,	
Name of Organization Running Log	

WELL GROUTED TO A DEPTH OF 50 FEET Type Grout (circle one): Cement, Bentonite, or Mix

GEOLOGIC DATA (Office Use Only)			
Surface Elev.	Geologic Unit	Unit Thickness	Depth to Top
Subs. SWL	Date	Analysis	Aquifer Test

SCREEN DATA		
Diameter - Inches 3"	Length - Feet 40'	Slot Size - Inches cut slots
Screen Type steel	Depth to Bottom - Feet 530'	

Driller's Remarks 1980' S E 330' E of NW/Cor
--

DESCRIPTION OF FORMATIONS ENCOUNTERED	FROM	TO	FORMATIONS (Continued)	FROM	TO
Clay	0	451			
Fine sand	451	471	(screened)		
Clay	471	515			
Sand (Fine)	515	530	(screened)		
clay	530	609			

RECEIVED


NOV 03 1994

Dept. of Environmental Quality
Office of Land & Water Resources

IF MORE SPACE IS NEEDED, USE BACK

If well telescopes please sketch and show depths.

GROUND LEVEL

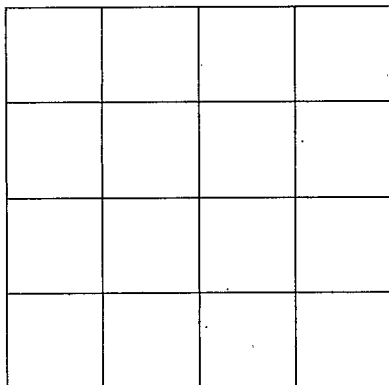

SECTION _____

Please indicate well location X.

ADDITIONAL INFORMATION

If more than one screen,
show location of each on sketch.