	State Well Report			
County: Rankin	Part 1 - Driller's Log	For Office Use Only:		
	sissippi Department of Environmental Quality	Aquifer: <u>D52</u>		
Permit #: 0-586	Office of Land and Water Resources P.O. Box 2309	Well #:		
Driller. JAMES WELLS	Jackson, MS 39225	L. S. Elevation:		
	(601)961-5210	L. S. Elevation:		
Date drilling completed: 6-1-1	(601)961- 5228 (fax)	E-log #:		
State Law requires that this report be prepared by the license holder responsible for the work and filed with the				
Design and the shows address within \$0 days of completion of artuing of the method boreners				
Information on Well Owner	, yven or o	OI CHOIC LOCATION		
(Landowner if borehole is not for a w	ater well) Latitude: <u>32.29, 4</u>	<u>1." Longitude: 89.55, 62.</u> "		
Owner Name Ryan Hydrick	Method of Lat/Long (circle o	one): Conventional Survey,		
Mailing Address: 408 Stull R		d GPS, Survey-grade GPS		
	NW 1/ SW 1/ Sec 21	O_TWN 7N RNg 4E		
Brandon MS	57097			
City State	Zip Code Distance Direction	Distance Direction Nearest Town		
Telephone No. (60) 038-4815				
Well / Borehole Data				
Date drilling started: 6-1-11 Date drilling completed: 6-1-11 Hole depth: 380 Hole diameter: 71/3'				
	for drilling: CLODING CREEK			
Method of dosing and volume of Chlorine used in drilling and development:				
Logs run (circle all applicable): No log run Electric Gamma Ray Density Sonic Neutron Other:				
Purpose of borehole (check one): Water Well K Geotechnical/Geological Investigation Ground Source Heat Pump				
Seismic Surve	yOther (describe)			
If drilling is not related to water well construction, skip the remainder of this block				
Purpose of Well (check one): Home Industrial Public Supply Irrigation Fish Culture Other:				
If a flowing well, method of flow regulation: Valve Other (describe)				
Static Water Level:feet above or below (circle one) land surface Date measured:				
Method of Measurement (circle one) steel tape electric tape air line other:				
Well depth: 280 Well grouted to a depth of 10 feet Type of grout (circle one): Neat Coment) Bentonite Mix				
Casing length: <u>260</u> feet Casing diameter: <u>4</u> inches Type of casing: <u>PVC</u>				
Screen length: <u>20</u> feet Screen diameter: <u>4</u> inches Type of screen: <u>PVC</u>				
Screen slot size: .008 inches Setting depth: From 240 feet to 380 feet				
Type of completion (circle all applicable): Gravel packed Underreamed Telescoped Open hole Natural Development				
Other (describe):				
Top of lap pipe or reduction in casing:fect. If telescoped or more than one screen, describe on next page				
		Form: OI WR-SWR-1A (04/08)		

- 7



JUL 2 1 **2011** BY: OLWR



Description of formations encountered must be provided for all

wells and boreholes, unless specifically exempted by regulations


The sketch below only required for water wells

If well telescopes, show depths on sketch. Ground Level_____

· 、 /

el	Description of Formations Encountered	From (depth)	To (depth)
K		Ground Level	
	Jan		20
	SANC	20	28
	Clay	28	240
	sand	240	288
			1
			+
			<u> </u>
			<u> </u>
			+
			+

If more than one screen, show location of each on sketch

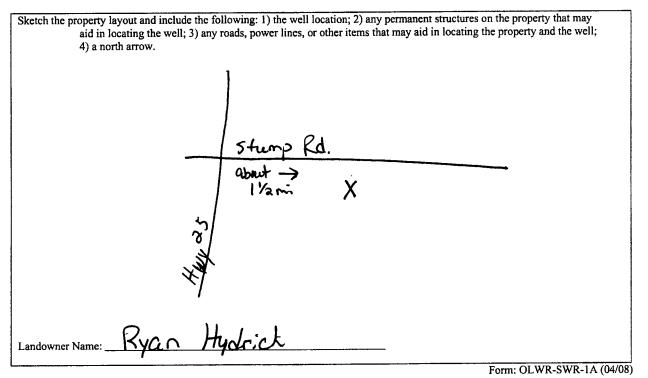

I certify that the well/borehole was drilled, constructed, and completed in accordance with all applicable requirements of the Mississippi Department of Environmental Quality and the Mississippi Department of Health regulations, if applicable, and state

JAMES WELLS 0-586

James Walls

Print Name of Responsible Licensee and License No.

Date

Signature of Licensee



JUL 2 1 2011 BY: OLWF

STATE WELL REPORT			
County: Rankin Ministeller	Part 2 For Office Use Only: S Completion Report ant of Environmental Quality and Water Resources		
Driller JAMES WELLS Jackson, J	Box 10631 Well#:		
Date completed: (601)3	54-6938 (fax)		
This report should be prepared by the pump installer in detail and filed with the Department the state of the installation of pump.			
Well Owner Information			
Owner Name: Ryan Hydrick	Latitude:Longitude:		
Mailing Address: 408 Stull Rd.	Method of Lat/Long (circle one): Conventional Survey,		
	USGS quad, Hand-held GPS, Survey-grade GPS		
Brandon MS 39047	14 Sec <u>20</u> Twn <u>7</u> N Rng <u>4</u> <u>7</u> <u>7</u> <u>7</u> <u>7</u> <u>8</u> <u>7</u> <u>7</u> <u>8</u> <u>7</u> <u>7</u> <u>8</u> <u>7</u> <u>7</u> <u>8</u>		
	Distance A		
Telephone No. (601) 238-4815	10 Miles N of Alowood		
	Power Type		
Pump Type Circle one	Circle one		
Air Lift Jet Submersible	Diesei Engine Gasoline Engine Natural Gas		
Bucket Piston Turbine	Electric Motor Hand Tractor PTO		
Centrifugal Rotary Flowing Well	Windmill Other (specify):		
Other (specify):	Horse Power Rating of Motor:		
Date Pump Installed:	Setting Depth:		
Rated Pump Capacity:Gallons Per Minute	Number of Stages:		
	Method of Meesuring Water Level		
Pump Test Data	Circle one		
Date Well Tested:	Air Line Electric Measuring Line Steel Taje		
Static Water Level (A): Feet Below Land Surface	Other (specify):		
Pumping Water Level (B): <u>100</u> Feet Below Land Surface	For flowing well, measured shut in head: feet		
Drawdown [(B) – (A)]: $\frac{45}{15}$ Feet Below Land Surface	Well yielded GPM with a drawdown of		
Test Pumping Rate:Gallons Per Minute	Well yleaded of hit what is determined of the second secon		
Duration of Pump Test (minimum 4 hours):hours	ICCI AREAROURA OF PROPERTY		
I HEREBY CERTIFY that the above statements are true to the best of my knowledge.			
JAMES WELLS O-586 Print Name of Pump Installer and License No. (if applicable) Signature of Pump Installer			

٠

4

RECEIVED

JUL 2 1 **2011** BY: OLWR