

RANKIN  
E14  
4-68

MISSISSIPPI  
BOARD OF WATER COMMISSIONERS  
416 North State Street  
Jackson, Mississippi 39201

**CODED**

WATER WELL DRILLERS LOG

4-10 1968 date well completed  
East Nailing firm name  
Rankin county well located

LANDOWNER: Billy Parker

description of formations encountered	from	to
Brown Clay	0	34
Blue Clay		152
Shale		205
Shale & silt rock		225
Gravelly Shelling		265
red sand & shale		286
Shale		307
Soft shale & silt sand		327
Fine sand & silt clay		348
Fine sand		389
Fine sand		418

Delahatchie, Miss  
(mailing address)

WELL LOCATION:  
sec. 31 T. 7 N R. 5 E  
8 miles North of Delahatchie  
(distance) (direction) (nearest town)

WELL PURPOSE: Home  
(home, irrigation, municipal, industrial)

WELL COMPLETION DATA:


- (1) diameter (inches) 2"
- (2) total depth (feet) 416
- (3) static water level (feet) 124 below top of ground.
- (4) casing Galv. 406  
(material) (depth)  
2"  
(size) if telescope see back.
- (5) screen 10 ft. 406  
(length) (depth to top)  
2" Solid Stainless  
(size) (material) Steel
- (6) pump 5 1500 GPM  
(HP) (yield gpm)  
Elect.  
(type power)
- (7) electric log No.  
(yes or no)

**CODED**

(organization running log)

(8) how well bottom plugged backwash  
value

DRILLERS REMARKS:

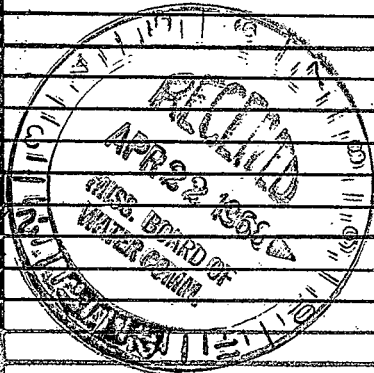

If well telescopes please sketch and show depths.

GROUND LEVEL


SECTION \_\_\_\_\_

Please indicate well location X.

ADDITIONAL INFORMATION

If more than one screen,  
show locations of each on sketch.