

RANKIN
E 15
3-68

MISSISSIPPI
BOARD OF WATER COMMISSIONERS
416 North State Street
Jackson, Mississippi 39201

CODED

WATER WELL DRILLERS LOG

3-26-68 date well completed Forest Drilling Co Rankin firm name county well located

LANDOWNER: J.W. Westwood
Rt 1 Box 132
Belahatchie, Miss
(mailing address)

WELL LOCATION:
sec. 31 T 6 N R 5 E
8 miles North Belahatchie
(distance) (direction) (nearest town)


WELL PURPOSE: Home
(home, irrigation, municipal, industrial)

WELL COMPLETION DATA:

- (1) diameter (inches) 2"
- (2) total depth (feet) 393 ft
- (3) static water level (feet) 140 below top of ground.
- (4) casing Galv 398 ft (material), (depth)
2" if telescope see back.
- (5) screen 15 ft 378 (length), (depth to top)
2" Brass (size), (material)
- (6) pump 3 1000 GPH (HP), (yield gpm)
Eest 220V (type power)
- (7) electric log No- (yes or no)
- (organization running log)
- (8) how well bottom plugged Good
Value

description of formations encountered	from	to
Green Clay	0	410
Blue Clay	102	143
Clay + other stuff sand	143	205
Clay + other stuff rock	205	225
Clay	225	275
Clay + other stuff	275	265
Sandy shell	265	287
Fin sand + clay	287	292
Fin sand	292	344
Clay	344	368
Fin sand	368	378
Fin sand + other clay	378	396
Fin sand	396	410


CODED

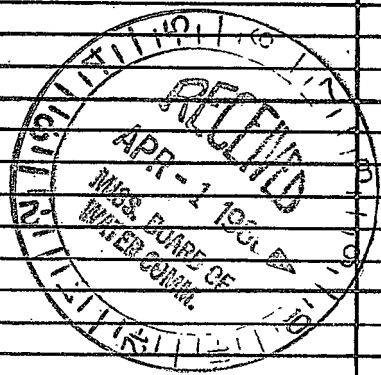

DRILLERS REMARKS:

If well telescopes please sketch and show depths.

GROUND LEVEL

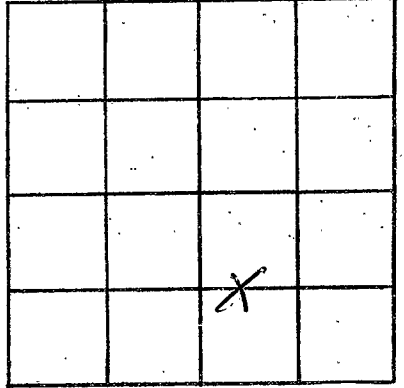

Rankin Co. SECTION 31

Please indicate well location X.

ADDITIONAL INFORMATION

If more than one screen, show locations of each on sketch.