

CODED

MISSISSIPPI
BOARD OF WATER COMMISSIONERS
416 North State Street
Jackson, Mississippi 39201

WATER WELL DRILLERS LOG

RANKIN
E 16
3-68

3-1-1968 date well completed J P Thornton firm name Perkins County county well located

LANDOWNER: J C Prestage
Morton Miss
Route
(mailing address)

WELL LOCATION:
sec. 27 T 7 N R 5 E
S W
5 miles SW of Morton
(distance) (direction) (nearest town)


WELL PURPOSE: home
(home, irrigation, municipal, industrial)

WELL COMPLETION DATA:

- (1) diameter (inches) 2"
- (2) total depth (feet) 425'
- (3) static water level (feet) 166' below top of ground.
- (4) casing galv, 4 1/2" (material) (depth)
- (size) if telescope see back.
- (5) screen 9' (length), 7' (depth to top)
- 2" (size), SS (material)
- (6) pump 230 comp 10 gal p mi (HP) (yield gpm)
- (type power)
- (7) electric log (yes or no) X
- (organization running log)
- (8) how well bottom plugged screen

description of formations encountered	from	to
Yellow chalk	50	50
Black dirt	75	125
rock + Black dirt	30	155
Blue mud	55	210
Shell + Black sand	40	250
Green dirt	160	350
Rock	4	354
Gray mud	52	406
light gray water sand	19	425

CODED

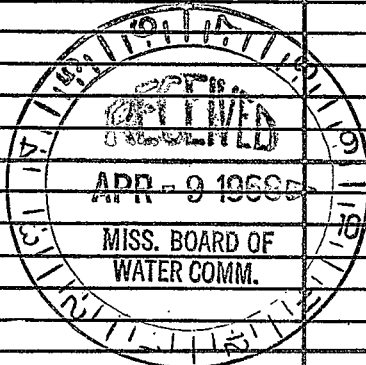

DRILLERS REMARKS: 600 gph

If well telescopes please sketch and show depths.

GROUND LEVEL

			X NE 1/4

SECTION _____

Please indicate well location X.

ADDITIONAL INFORMATION

If more than one screen,
show locations of each on sketch.