

RANKIN

E21

6-22-61

WATER WELL DRILLERS LOG **CODED**

Date: 6/22, 1961, Driller: James McGee County Rankin  
 (Name)

(1) Owner of Land: Troy King  
 (Name)  
 This well located about 10 miles  
North East of Pelahatchie.  
 (Address)

(2) Location: 1/4, 1/4, Sec. 17 TRS  
10 miles Northeast of Pelahatchie  
 (distance) (direction) (Nearest Town)

(3) Topography: X  
 (Hilly) (Flat) (Level)

(4) Purpose of Well: Domestic.  
 (Domestic Irrigation  
 Municipal, Industrial, Other)

Description & Color of Materials Sand, Clay, Red Clay, Shell, etc.	Thick- ness Feet	Depth Feet
Brown clay.	0-	32
<del>Blue</del> Blue clay.	32-	102
Gumbo.	102-	162
Clay.	162-	200
Clay & stks. lime rock.	200-	207
Sandy shell.	207-	222
Fine sand & stks. clay.	222-	245
Shale & stks. rock.	245-	252
Shale & stks. fine sand.	252-	272
Shale & stks. rock.	272-	282
Shale.	282-	292
Shale & stks. fine sand.	292-	312
Hard shale & stks. rock.	312-	402
Fine sand & stks. clay.	402-	412
Clay & stks. fine sand.	412-	422
Shale.	422-	433
Fine sand.	433-	446
Fine sand & stks. clay.	446-	466
Sand. (Screen setting)	466-	486


Information upon completion of well:

- (1) Diameter 2 inches.
- (2) Total Depth 486 feet.
- (3) Water Level 130 feet below top of ground.
- (4) Cased to 471', Size 2"
- (5) Screen: Size 2", Length 15'
- (6) Were any formations sealed against pollution?  
yes, X no.

If YES depth of formation \_\_\_\_\_

Why \_\_\_\_\_

Drillers Remarks: Good well.

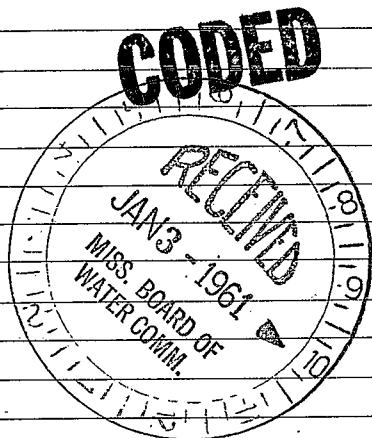

(Use Back Side)

Well No.

