

RANKIN

MISSISSIPPI BOARD OF WATER COMMISSIONERS

J

~~FE~~ 23

7-12-62

WATER WELL DRILLERS LOG

**CODED**

Rankin  
Forest

Date: 7/12, 1962, Driller:



FOREST DRILLING SERVICE

231 Hwy. 35 County

(Name Forest, Miss.)

- (1) Owner of Land: CR Rungler  
(Name)  
Delbatchie  
(Address)
- (2) Location: 1/4, 1/4, Sec. 14 T 7R S  
1/2 miles North, of Delbatchie  
(distance) (direction) (Nearest Town)
- (3) Topography: X  
(Hilly) (Flat) (Level)
- (4) Purpose of Well: Home  
(Domestic Irrigation  
Municipal, Industrial, Other)

Description of Materials Sand, Clay, Red Clay, Shell, etc.	Thick-ness Feet	Depth Feet
Brown Clay	0	26
Blue Clay	34	160
Clay + lined rock	5	165
Sandy shell	15	180
Clay + shell	10	190
Shale	10	200
Fine sand	15	215
Shale + shells	15	230
Fine sand	10	240
Mucky sand	15	255
Soft shale + shells	15	270
Shale	38	308
Shale + shells	12	320
Fine sand + shells	10	330
Fine sand	20	350
Fine sand	10	360

Information upon completion of well:


- (1) Diameter 2" inches.
- (2) Total Depth 360 feet.
- (3) Water Level 100 feet below top of ground.
- (4) Cased to 250, Size 2"
- (5) Screen: Size 2", Length 10 ft
- (6) Were any formations sealed against pollution?  
\_\_\_\_\_ yes, X no.

If YES depth of formation \_\_\_\_\_

Why \_\_\_\_\_

Drillers Remarks: \_\_\_\_\_

**CODED**

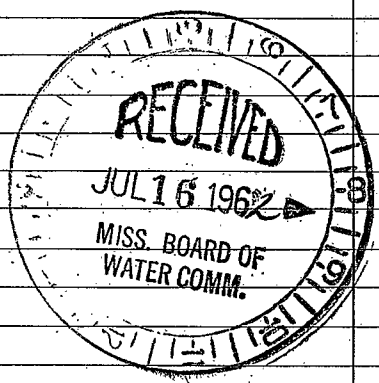

(Use Back Side)

Well No.

3265