

~~J-30~~ E 25

6-16-63

WATER WELL DRILLERS LOG

**CODED**

Date: 6-16, 1963, Driller: Just W. G. Sew County: Scott  
 (Name)

(1) Owner of Land: Johnnie Walker  
 (Name)  
Delehatie, Miss.  
 (Address)

(2) Location: 1/4, 1/4, Sec. 28 T 7 R 5  
 (distance) (direction) (Nearest Town)

(3) Topography: \_\_\_\_\_  
 (Hilly) (Flat) (Level)

(4) Purpose of Well: Home  
 (Domestic Irrigation  
 Municipal, Industrial, Other)

Description & Color of Materials Sand, Clay, Red Clay, Shell, etc.	Thick- ness Feet	Depth Feet
<u>Brown Clay</u>	<u>2</u>	<u>30</u>
<u>Blue Clay</u>	<u>30</u>	<u>226</u>
<u>Gravel Shell</u>		<u>246</u>
<u>Clay &amp; 5th Shell</u>		<u>266</u>
<u>Clay &amp; 4th fine sand</u>		<u>286</u>
<u>fine sand &amp; clay</u>		<u>332</u>
<u>Clay &amp; 4th fine sand</u>		<u>357</u>
<u>4th sand &amp; clay</u>		<u>409</u>
<u>Clay</u>		<u>430</u>
<u>Clay</u>		<u>440</u>
<u>fine sand</u>		<u>477</u>

Information upon completion of well:

(1) Diameter 2" inches.

(2) Total Depth 477 feet.

(3) Water Level 120 feet below top of ground.

(4) Cased to 462, Size 2"

(5) Screen: Size 2", Length 15'


(6) Were any formations sealed against pollution?  
 \_\_\_\_\_ yes,  no.

If YES depth of formation \_\_\_\_\_

Why \_\_\_\_\_

Drillers. Remarks: \_\_\_\_\_

**CODED**

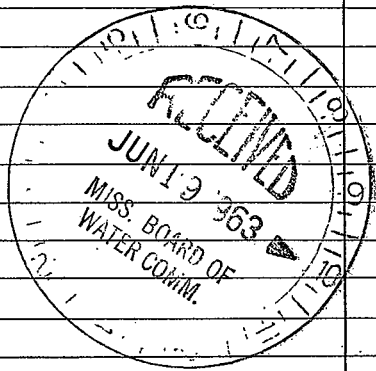

(Use Back Side)

Well No.

100

100