

RANKIN MISSISSIPPI BOARD OF WATER COMMISSIONERS

~~NO. 29~~

10-31-63

WATER WELL DRILLERS LOG

CODED

Date: 10/31, 1963, Driller: Frank Delger County: Scott
(Name)

(1) Owner of Land: B. C. Marshall
(Name)
Delehatie Miss.
(Address)

(2) Location: 1/4, 1/4, Sec. 5 T. 25
2 miles South, of Delehatie
(distance) (direction) (Nearest Town)

(3) Topography: X
(Hilly) (Flat) (Level)

(4) Purpose of Well: Home
(Domestic Irrigation
Municipal, Industrial, Other)

Description & Color of Materials Sand, Clay, Red Clay, Shell, etc.	Thick- ness Feet	Depth Feet
Brown clay	0	38
Blue clay		142
Clay & lime rock		152
Shale		162
tender shell		172
Clay & shells		192
Shale		242
fine sand & shells		262
Clay & shells		302
Shale		310
soft shale		340
fine sand		350
fine sand & shells		360

Information upon completion of well:

(1) Diameter 2 inches.

(2) Total Depth 360 feet.

(3) Water Level 140 feet below top of ground.

(4) Cased to 340, Size 2"

(5) Screen: Size 2", Length 20 ft.


(6) Were any formations sealed against pollution?
 _____ yes, X no.

If YES depth of formation _____

Why _____

Drillers Remarks: _____

CODED

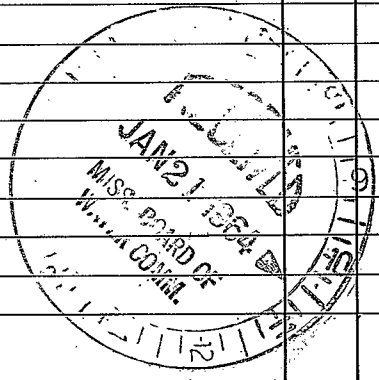

(Use Back Side)

Well No.

100

100

