

RANKIN MISSISSIPPI BOARD OF WATER COMMISSIONERS

JES E 30

2-20-65

WATER WELL DRILLERS LOG

CODED

Date 2/20, 1965, Driller: Forest Drilling County Forest
(Name)

(1) Owner of Land: O. D. Bilbro
(Name)
Rt 1 - Relatchie, Miss
(Address)

(2) Location: 1/4, 1/4, Sec. 3 T 7 R 5
North of Relatchie
(distance) (direction) (Nearest Town)

(3) Topography: Flat
(Hilly) (Flat) (Level)

(4) Purpose of Well: Shop
(Domestic Irrigation, Municipal, Industrial, Other)

Description & Color of Materials Sand, Clay, Red Clay, Shell, etc.	Thick-ness Feet	Depth Feet
Brown Clay		27
Blue Clay		102
Clay + sh. fine sand		132
Clay		182
Clay + Rock		192
Sandy Shell		212
Clay + sh. Mly sand		222
Clay + Rock		232
Shell		282
Sh. + sh. f. sand		302
Shale		367
Shale + sh. Rock		377
Clay + sh. sand		387
Fine sand		447

Information upon completion of well:

(1) Diameter 2 inches.

(2) Total Depth 447 feet.

(3) Water Level 126 feet below top of ground.

(4) Cased to 432, Size 2"

(5) Screen: Size 2", Length 157k.


(6) Were any formations sealed against pollution?
 _____ yes, X no.

CODED

If YES depth of formation _____

Why _____

Drillers Remarks: _____

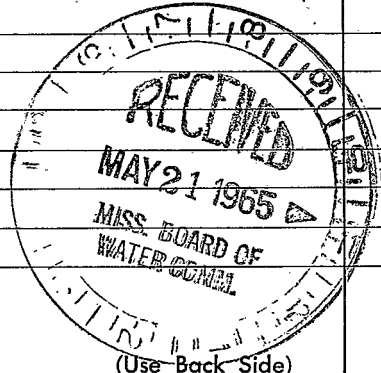

Well No.

