

MISSISSIPPI DEPARTMENT OF NATURAL RESOURCES

Bureau of Land and Water Resources

Southport Mall

P.O. Box 10631

Jackson, Mississippi 39209

WATER WELL DRILLERS LOG

Griner Drilling Service, Inc.

Rankin

COPIED

RANKIN
E 34
4-1-82

4-1-82 date well completed

Griner Drilling Service, Inc. firm name

Rankin county well located

LANDOWNER:

Shell Oil Company
P.O. Box 61555
New Orleans, La 70160
(mailing address)

description of formations encountered

from

to

chalk, rock	0	210
sand, shell	210	231
chalk, streaked	231	273
chalk, sand	273	294
sand	294	410
chalk	410	441

WELL LOCATION: 1500' N + 1500' E

sec. 29 T. 7 N. R. 5 E of SW 1/4

No. 2 McKay Hollybrush Creek
et al. (distance) (location of field) (nearest town)

WELL PURPOSE: oil field supply
(home, irrigation, municipal, industrial)

WELL COMPLETION DATA:

- (1) diameter (inches) 4"
- (2) total depth (feet) 441'
- (3) static water level (feet) 70' below top of ground
- (4) casing steel 399' (material) (depth)
4" (size) if telescope see back.
- (5) screen 42' 357' (length) (depth to top)
4" perforated (size) (material)
- (6) pump (HP) 70 (yield gpm)
AC (type power)
- (7) electric log (yes or no)

(organization running log)

- (8) how well bottom plugged orange peel

DRILLERS REMARKS:


DEPT. OF NATURAL RESOURCES
BUREAU OF LAND & WATER RESOURCES

APR 10 1982

RECEIVED

If well telescopes please sketch and show depths.

GROUND LEVEL

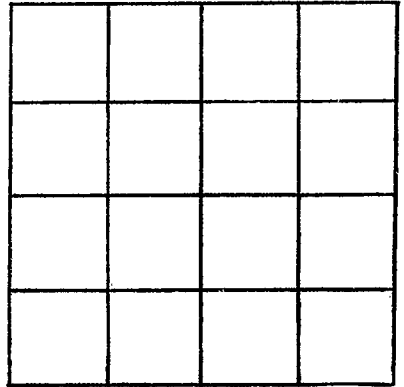

SECTION _____

Please indicate well location X.

ADDITIONAL INFORMATION

If more than one screen, show locations of each on sketch.