

RANKIN MISSISSIPPI BOARD OF WATER COMMISSIONERS

F27

Elect & Mass Geolocal Survey

3-8-65

WATER WELL DRILLERS LOG

CODED (Rankin)

Date: 3-8-65, Driller: James McNeese County: Hinds

(Name)

(1) Owner of Land: National Sales Co
(Name)
FANNIN ROAD JACKSON
(Address)

(2) Location: E 1/4, NW 1/4, Sec 33 T.6R2
5 miles East of JACKSON
(distance) (direction) (Nearest Town)

(3) Topography: ✓
(Hilly) (Flat) (Level)

(4) Purpose of Well: Industrial
(Domestic Irrigation Municipal, Industrial, Other)

Description & Color of Materials Sand, Clay, Red Clay, Shell, etc.	Thick- ness Feet	Depth Feet
SURFACE SOIL	15	15
SAND	10	25
Grey shale	65	90
Blue sh. sand shells	10	100
Blue sh. LIGNITE	20	120
Blue-grey shale	105	225
ROCK.	1	226
SAND	14	240
Grey sh. sd. STKS. Lignite	40	280
SAND. FINE	92	372
BROWN sh. lime STKS	203	575
SAND sh. STKS	28	603
Grey sh	40	643
SAND	55	698
SAND sh STKS	65	763
SAND	29	802
36 STS-2"	756	
3-2" .008 SSS	30	
1-ST 2" with BPV	786	
	12	
	798	

Information upon completion of well:

(1) Diameter: 6" x 4 1/2" x 3 1/4" inches.

(2) Total Depth: 802 feet.

(3) Water Level: 120 feet below top of ground.

(4) Cased to: 786', Size: 2"

(5) Screen: Size: 2" .008, Length: 30


(6) Were any formations sealed against pollution?
_____ yes, ✓ no.

If YES depth of formation _____

Why _____

Drillers Remarks: _____

CODED

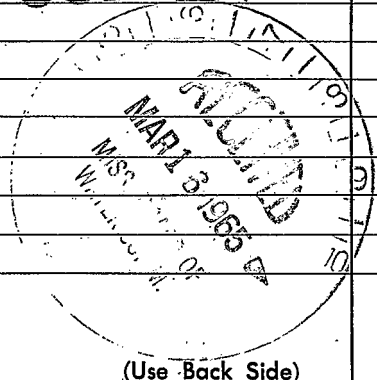

(Use Back Side)

Well No.

(K)

9313