

Rankin
730
11-67
Elec Log
11-22-67 19

MISSISSIPPI
 BOARD OF WATER COMMISSIONERS
 416 North State Street
 Jackson, Mississippi 39201

MES
75
CODED

WATER WELL DRILLERS LOG

Gordon McNEES

RANKLIN

date well completed

firm name

county well located

LANDOWNER: Metropolitan Water Co

description of formations encountered

from to

Lamar Life Bldg.
JACKSON MISS
 (mailing address)

clay	0	25
sand	25	27
Blue shale	27	330
Grey sdv sh	330	366
Grey shale	366	379
Grey sh sd strk	379	408
sand	408	418
Grey sh sd strk	418	514
sand	514	539
Grey sdv sh sd strk	539	559
sand	559	658
sand sh strk	658	661
Grey sh sd strk	661	683

WELL LOCATION:


sec 23 T 6 N R 2 E
6 miles NW of Brandon
 (distance) (direction) (nearest town)

WELL PURPOSE: system
 (home, irrigation, municipal, industrial)

WELL COMPLETION DATA:

- (1) diameter (inches) 4" x 2 1/2"
- (2) total depth (feet) 683
- (3) static water level (feet) 109 below above top of ground.
- (4) casing steel 604
 (material) (depth)
4" x 2 1/2" If telescope see back.
 (size)
- (5) screen 40' 604
 (length) (depth to top)
2 1/2" stainless steel
 (size) (material)
- (6) pump 5 40
 (HP) (yield gpm)
Elec
 (type power)
- (7) electric log yes
 (yes or no)
M.G.S.
 (organization running log)
- (8) how well bottom plugged good

DRILLERS REMARKS: Water clear

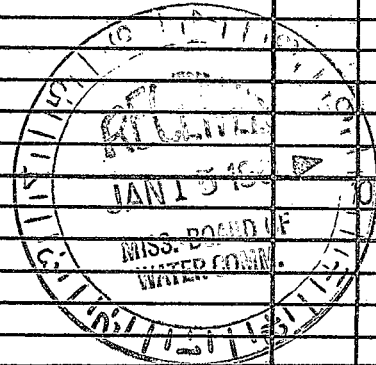

If well telescopes please sketch and show depths.

GROUND LEVEL

4" Pipe

359

4" x 2 1/2' screen

1
360

2 1/2" Pipe


244
604

2 1/2" screen

40
644

2 1/2" Pipe

21
665

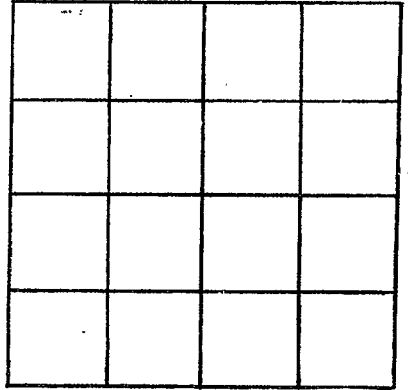

SECTION 23

Please indicate well location X.

ADDITIONAL INFORMATION

If more than one screen, show locations of each on sketch.