

RANKIN  
F 31  
1-63

MISSISSIPPI BOARD OF WATER COMMISSIONERS

WATER WELL DRILLERS LOG **CODED**

Date: JAN, 1963, Driller: MCNEECE DRILLING CO. County RANKIN

(Name)

	Description & Color of Materials Sand, Clay, Red Clay, Shell, etc.	Thick- ness Feet	De- pth Feet
(1) Owner of Land: <u>J.G. WIRTZ JR.</u> (Name)	SURFACE SOIL	3	3
<u>RT. 4 Box 208, JACKSON MISS</u> (Address)	WHITE SHALE	12	15
(2) Location: <u>SE</u> $\frac{1}{4}$ , <u>NE</u> $\frac{1}{4}$ , Sec. <u>13</u> T. <u>6N</u> R. <u>2E</u>	BROWN SHALE	20	35
<u>5</u> miles <u>NE</u> of <u>FLOWOOD</u> (distance) (direction) (Nearest Town)	WHITE SHALE	5	40
(3) Topography: <u>HILLY</u> (Hilly) (Flat) (Level)	GREY SHALE	412	452
(4) Purpose of Well: <u>DOMESTIC</u> (Domestic Irrigation Municipal, Industrial, Other)	SAND, SHELL + SHALE	14	466
	SAND, SHALE + LIGNITE	43	509
	FINE SAND	22	531
	SAND + SHALE	106	637
	COARSE SAND	63	700
	SHALE	22	722

Information upon completion of well:

- (1) Diameter 4x2 inches.
- (2) Total Depth 722 feet.
- (3) Water Level 173 feet below top of ground.
- (4) Cased to 338, Size 4"  
338 to 722 - 2"
- (5) Screen: Size 2", Length 20'
- (6) Were any formations sealed against pollution?  
no


yes,  no.

If YES depth of formation \_\_\_\_\_

Why \_\_\_\_\_

Drillers Remarks: \_\_\_\_\_

**CODED**

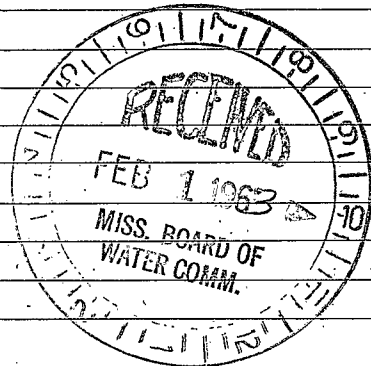

(Use Back Side)

Well No. 47

22-50  
2 | 45  
20