

RANKIN
F32
10-63

MISSISSIPPI BOARD OF WATER COMMISSIONERS

WATER WELL DRILLERS LOG

CODED

Date: OCT, 1963, Driller: MCNEECE DRILLING County: RANKIN
(Name CO.)

(1) Owner of Land: LIBERTY BAPTIST CHURCH
(Name)

R4, JACKSON MISS
(Address)

(2) Location: 1/4, SW 1/4, Sec. 23, T. 6 N. R. 2 E

6 miles NE, of JACKSON
(distance) (direction) (Nearest Town)

(3) Topography: FLAT
(Hilly) (Flat) (Level)

(4) Purpose of Well: CHURCH
(Domestic Irrigation
Municipal, Industrial, Other)

Description & Color of Materials
Sand, Clay, Red Clay, Shell, etc.

Thick-
ness
Feet

Depth
Feet

SURFACE SOIL	15	15
WHITE SAND	25	40
GREY SHALE	236	276
ROCK + SHALE	8	284
SHELL, SHALE + SAND	21	305
SHALE + SAND	82	387
COARSE SAND	66	453

CODED

Information upon completion of well:

(1) Diameter 4 1/2 inches.

(2) Total Depth 453 feet.

(3) Water Level 106 feet below top of ground.

(4) Cased to 302', Size 4"
302' - 453' - 2"

(5) Screen: Size 2", Length 20'


(6) Were any formations sealed against pollution?

X yes, X no.

If YES depth of formation _____

Why _____

Drillers Remarks: _____

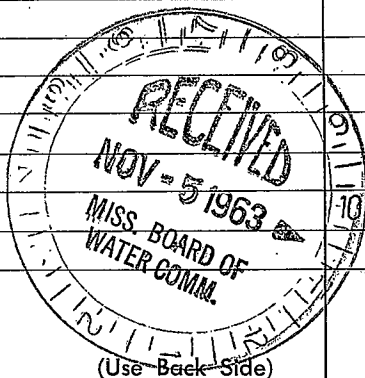

Well No.
62

300