

Rankin
 R33
 6-68

MISSISSIPPI
 BOARD OF WATER COMMISSIONERS
 416 North State Street
 Jackson, Mississippi 39201

CODED

WATER WELL DRILLERS LOG

6-28-1968 date well completed
 Rust Drilling firm name
 Rankin county well located

LANDOWNER: Edd Hoag
multiple ownership
P.O. Box 1019
Jackson Miss.
 (mailing address)

WELL LOCATION:
 sec. 23 T. 6N R. 2E
3 miles (distance) East (direction) of Flower (nearest town)

WELL PURPOSE: Home
 (home, irrigation, municipal, industrial)

- WELL COMPLETION DATA:
- (1) diameter (inches) 2"
 - (2) total depth (feet) 666 ft
 - (3) static water level (feet) 179 below above top of ground.
 - (4) casing Galv. 651 (material) (depth)
2" (size) if telescope see back.
 - (5) screen 157 (length) 651 (depth to top)
2" (size) Crushed (material) Gravel
 - (6) pump _____ (HP) _____ (yield gpm)
 _____ (type power)
 - (7) electric log _____ (yes or no)
 _____ (organization running log)
 - (8) how well bottom plugged _____

description of formations encountered	from	to
Brown Clay	0	24
Blue Clay		566
Shale		389
Dark Shale + Sths. Clay		432
Shale		452
Dark Shale + Sths. Clay		453
Shale + Sths. Clay		615
Shale		621
Shale + Sths. Clay		651
Light Sand + Clay		675
Clay + Fine Sand		695
Clay		705
Fine Sand		715
Shale		751


CODED

MISSISSIPPI BOARD OF WATER COMMISSIONERS

DRILLERS REMARKS:

If well telescopes please sketch and show depths.

GROUND LEVEL

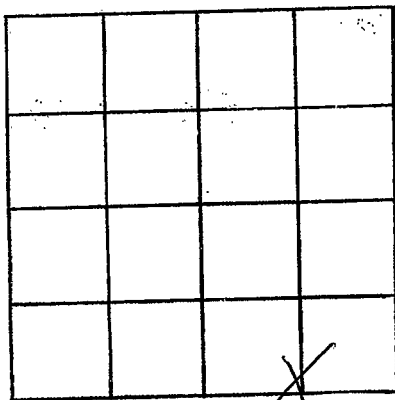

SECTION 23

Please indicate well location X.

ADDITIONAL INFORMATION

If more than one screen, show locations of each on sketch.