

Rankin  
 F-34  
 6-68

MISSISSIPPI  
 BOARD OF WATER COMMISSIONERS  
 416 North State Street  
 Jackson, Mississippi 39201

**CODED**

WATER WELL DRILLERS LOG

6-28 19 68 date well completed  
 Trust Drilling firm name  
 Rankin county well located

LANDOWNER: C. L. McNamee  
 Rt 4 Box 190  
 Jackson Miss  
 (mailing address)

WELL LOCATION:  
 sec. 35 T 6 N R 2 E  
 1 miles East of Airport  
 (distance) (direction) (nearest town)

WELL PURPOSE: Home  
 (home, irrigation, municipal, industrial)

- WELL COMPLETION DATA:
- (1) diameter (inches) 2"
  - (2) total depth (feet) 592 ft
  - (3) static water level (feet) 193 below top of ground.
  - (4) casing 5 7/8" Galv Steel (material) (depth)
  - 2" if telescope see back. (size)
  - (5) screen 15 ft, 5 7/8" (length) (depth to top)
  - 2" Galv Steel (size) (material)
  - (6) pump 5 HP 1100 GPH. (HP) (yield gpm)
  - Electric (type power)
  - (7) electric log No (yes or no)
  - (organization running log)
  - (8) how well bottom plugged

description of formations encountered	from	to
Brown Clay	0	30
Blue Clay	30	102
Blue Clay + Sand	102	208
Blue Clay Rock	208	370
Shale	370	391
Shale + thin beds	391	473
Thin sand with clay	473	524
Fine sand	524	592


**CODED**

EX-101-215-11908  
 MISS. BOARD OF  
 WATER COMMISSIONERS

DRILLERS REMARKS:

If well telescopes please sketch and show depths.

GROUND LEVEL

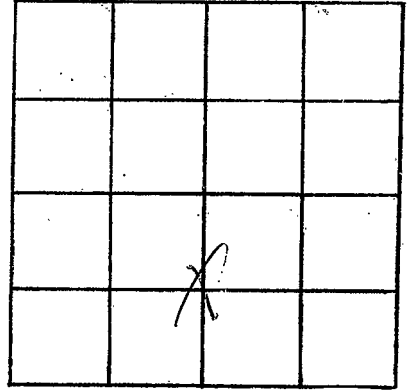

SECTION 35

Please indicate well location X.

ADDITIONAL INFORMATION

If more than one screen,  
show locations of each on sketch.