

RANKIN  
F35  
9-19-60

MISSISSIPPI BOARD OF WATER COMMISSIONERS

WATER WELL DRILLERS LOG **CODED**

Date: 9/19, 1960, Driller: Johnnie Beasley County Rankin  
(Name)

(1) Owner of Land: L. A. Bolton  
(Name)  
Rt. 4, Jackson, Miss.  
(Address)

(2) Location: 1/4, 1/4, Sec 27 T6 R2  
4 miles North, of Flowood  
(distance) (direction) (Nearest Town)

(3) Topography: X  
(Hilly) (Flat) (Level)

(4) Purpose of Well: Domestic  
(Domestic Irrigation  
Municipal, Industrial, Other)

Description & Color of Materials Sand, Clay, Red Clay, Shell, etc.	Thick- ness Feet	Depth Feet
Silt.	0	16
Sand.	16	25
Blue Clay.	25	227
Shale & Stks. rock.	227	267
Silt, shell & soft clay		
	267	310
Silt & clay.	310	330
Fine sand.	330	371
Shale.	371	391
Mucky sand.	391	412
Silt sand.	412	432
Fine sand.	432	494
Sand. (Screen Set)	494	514

Information upon completion of well:

(1) Diameter 2 inches.

(2) Total Depth 514 feet.

(3) Water Level 85 feet below top of ground.

(4) Cased to 494', Size 2"


(5) Screen: Size 2", Length 10'

(6) Were any formations sealed against pollution?  
yes, X no.

If YES depth of formation \_\_\_\_\_  
Why \_\_\_\_\_

Drillers Remarks: Good well.

**CODED**

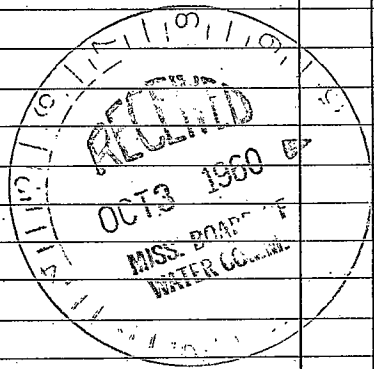

(Use Back Side)

Well No.

