

RANKIN MISSISSIPPI BOARD OF WATER COMMISSIONERS

F38

10-18-61

WATER WELL DRILLERS LOG

CODED

F

Date: 10/18, 1961, Driller: James McGee County Rankin
(Name)

(1) Owner of Land: William O. Woxson
(Name)
 This well located above Flowood about
Rt. 4, Box 224BB, Jackson 8, Miss.
(Address)
5 miles.
 (2) Location: 1/4, 1/4, Sec. 28 T6 R2,
_____ miles of _____ of _____
(distance) (direction) (Nearest Town)
 (3) Topography: X
(Hilly) (Flat) (Level)
 (4) Purpose of Well: Dome stic.
(Domestic Irrigation Municipal, Industrial, Other)

Description & Color of Materials Sand, Clay, Red Clay, Shell, etc.	Thick- ness Feet	Depth Feet
Brown clay.		0-12
Sand.		12-32
Blue clay.		32-182
Clay.		182-200
Clay & rock.		200-206
Mucky sand & shell.		206-228
Shale.		228-242
Mucky sand & shale.		242-252
Shale.		252-262
Mucky clay & sand.		262-272
Mucky clay.		272-312
Shale.		312-352
Sand & stks. clay.		352-362
Mucky clay & stks. sand.		362-402
Fine sand & stks. clay.		402-436
Fine sand.		436-466
Sand. (Screen setting)		466-503

Information upon completion of well:


- (1) Diameter 2 inches.
 (2) Total Depth 503 feet.
 (3) Water Level 83' feet below top of ground.
 (4) Cased to 188', Size 2"
 (5) Screen: Size 2", Length 15'
 (6) Were any formations sealed against pollution?
_____ yes, X no.

If YES depth of formation _____

Why _____

Drillers Remarks: Good well.

CODED

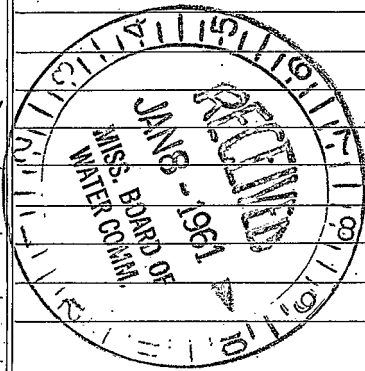

(Use Back Side)

Well No.

