

RANKIN

MISSISSIPPI BOARD OF WATER COMMISSIONERS

F39

8-2-65

WATER WELL DRILLERS LOG

RANKIN  
CODED  
Hinds

Date: 8/2, 1965, Driller: Forest Shelling, Sec. 27, County: Hinds

(Name)

(1) Owner of Land: C. H. Wright  
Airport Road North  
Jackson, Miss.  
(Address) 939-3150

(2) Location: 1/4, 1/4, Sec 27 T6 R2  
miles of  
(distance) (direction) (Nearest Town)

(3) Topography:  (Hilly)  (Flat)  (Level)

(4) Purpose of Well: Home  
(Domestic Irrigation, Municipal, Industrial, Other)

Description & Color of Materials Sand, Clay, Red Clay, Shell, etc.	Thick- ness Feet	Depth Feet
Chalky Clay	0	18
Sand	-	30
Blue Clay		160
Blue Shale (Hard)		245
Rock & Shale		257
Lime Rock & Shell		286
Shale		306
Shale & Sh. Silt		348
Shale		358
Fine Sand		477

Information upon completion of well:

(1) Diameter 2 inches.

(2) Total Depth 477 feet.

(3) Water Level 105 feet below top of ground.

(4) Cased to 372, Size 2"

(5) Screen: Size 2", Length 15 ft.


(6) Were any formations sealed against pollution?  
 yes,  no.

If YES depth of formation

Why

Drillers Remarks:

**CODED**

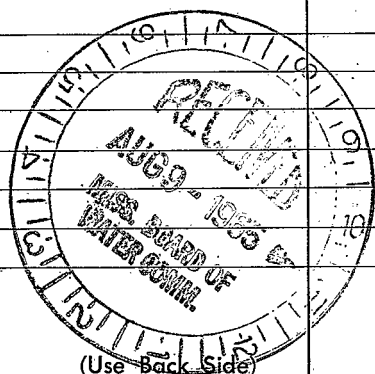

Well No.

1954