

RANKIN
F42
7-3-70

MISSISSIPPI
BOARD OF WATER COMMISSIONERS
416 North State Street
Jackson, Mississippi 39201
WATER WELL DRILLERS LOG

ELOG# 272

CODED

7/3/70 Forest Drilling Rankin
date well completed firm name county well located

LANDOWNER:
Jackson Preparation Dept.
Jackson Miss.
(mailing address)

description of formations encountered from to

WELL LOCATION:
sec. 29 T. 6 N. R. 2 E
2 miles E of Jackson
(distance) (direction) (nearest town)

Yellow clay	0	14
Coarse sand + gravel	14	32
Blue clay	32	104
Shale, lime, shale + shell	104	124
Brown clay + sh. lignite	124	148
Soft clay	148	238
Sh. clay & sand	238	258
Fine sand	258	273
Soft clay	273	333
Sh. shale + fine sand	333	338
Fine sand	338	378
Clay	378	384
Green fine sand	384	404

WELL PURPOSE: school
(home, irrigation, municipal, industrial)

WELL COMPLETION DATA:

- (1) diameter (inches) 6"
- (2) total depth (feet) 408'
- (3) static water level (feet) 100' below top of ground.
- (4) casing Steel 327' (material) (depth)
6" (size) if telescope see back.
- (5) screen 50' 341' (length) (depth to top)
4" Stainless Steel (size) (material)
- (6) pump 10 90 (HP) (yield gpm)
Eject (type power)
- (7) electric log Yes (yes or no)
Miss. Geological (organization running log)
- (8) how well bottom plugged 2" Backward Valve

CODED


DRILLERS REMARKS:

AUG 6 1970

(X)

If well telescopes please sketch and show depths.

GROUND LEVEL

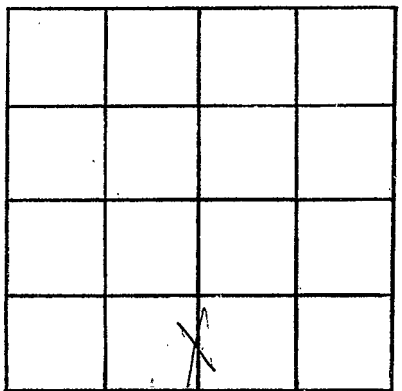

SECTION 29

Please indicate well location X.

ADDITIONAL INFORMATION

Multiple horizontal lines provided for additional information.

If more than one screen, show locations of each on sketch.