

F, 43
6-12-61

WATER WELL DRILLERS LOG

CODED ✓

Date: 6/12, 1961, Driller: Johnnie Beasley County Rankin.

(Name)

(1) Owner of Land: Ernest Luter.

(Name)

Jackson, Miss.

(Address)

(2) Location: 1/4, 1/4, Sec. 14 6-2 T. R

15 miles North of Jackson
(distance) (direction) (Nearest Town)

(3) Topography: X
(Hilly) (Flat) (Level)

(4) Purpose of Well: Domestic.
(Domestic Irrigation
Municipal, Industrial, Other)

Description & Color of Materials Sand, Clay, Red Clay, Shell, etc.	Thick- ness Feet	Depth Feet
<u>Yellow clay.</u>	<u>0</u>	<u>36</u>
<u>Blue clay.</u>	<u>36</u>	<u>327</u>
<u>Shale.</u>	<u>327</u>	<u>365</u>
<u>Silt.</u>	<u>365</u>	<u>369</u>
<u>Rock.</u>	<u>369</u>	<u>371</u>
<u>Lime, shell & shale.</u>	<u>371</u>	<u>410</u>
<u>Shale & stks. silt.</u>	<u>410</u>	<u>570</u>
<u>Sand & stks. shale.</u>	<u>570</u>	<u>586</u>
<u>Fine sand.</u>	<u>586</u>	<u>600</u>
<u>Sand. (Screen set.)</u>	<u>600</u>	<u>656</u>


Information upon completion of well:

- (1) Diameter 4X2 inches.
- (2) Total Depth 656 feet.
- (3) Water Level 115 feet below top of ground.
- (4) Cased to 631', Size 250' - 4", 404' - 2"
- (5) Screen: Size 2", Length 25'
- (6) Were any formations sealed against pollution?
no.

If YES depth of formation _____
Why _____

Drillers Remarks: Good well.

CODED

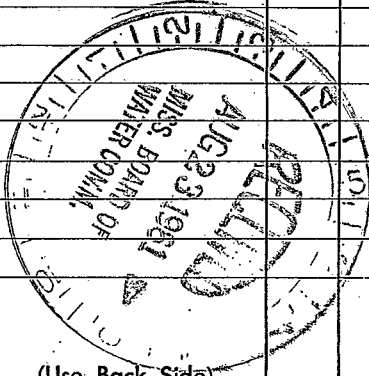

(Use Back Side)

Well No.

..... 27

.....

.....

11

11

