

ELOG #340

RANKIN

F45

10-18-71

MISSISSIPPI
BOARD OF WATER COMMISSIONERS
416 North State Street
Jackson, Mississippi 39201

CODED
MAY 15 1972

WATER WELL DRILLERS LOG


10-18 1971 date well completed *Forest Drilling Co.* firm name *Rankin* county well located

LANDOWNER: <i>C. L. McNamee</i>	description of formations encountered		from	to
<i>Route 4, Jackson</i>	<i>Yellow Clay</i>		<i>0</i>	<i>27</i>
	<i>Blue Clay</i>		<i>27</i>	<i>243</i>
	<i>Blue shale</i>		<i>243</i>	<i>386</i>
	<i>Shale + Shls Rock</i>		<i>386</i>	<i>395</i>
(mailing address)	<i>Shale</i>		<i>395</i>	<i>403</i>
WELL LOCATION:	<i>shale + Shls rock</i>		<i>403</i>	<i>423</i>
sec. <i>35</i> T. <i>6</i> N. R. <i>2</i> E	<i>Shale + Limestone</i>		<i>423</i>	<i>463</i>
<i>Near Jackson Airport</i>	<i>Shale</i>		<i>463</i>	<i>483</i>
(distance) miles (direction) of (nearest town)	<i>Shale + Shls silt</i>		<i>483</i>	<i>503</i>
WELL PURPOSE: <i>Municipal</i>	<i>Fine sand + Shls shale</i>		<i>503</i>	<i>523</i>
(home, irrigation, municipal, industrial)	<i>Fine sand</i>		<i>523</i>	<i>595</i>
WELL COMPLETION DATA:	<i>Shale + Shls sand</i>		<i>595</i>	<i>603</i>
(1) diameter (inches) <i>4 x 2 1/2"</i>				
(2) total depth (feet) <i>596 ft.</i>				
(3) static water level (feet) <i>16'</i> below above top of ground.				
(4) casing <i>Steel</i> <i>571'</i> (material) (depth)				
<i>4" x 2 1/2"</i> (size) if telescope see back.				
(5) screen <i>25 ft.</i> <i>571'</i> (length) (depth to top)				
<i>3"</i> (size) <i>Stainless Steel</i> (material)				
(6) pump <i>5</i> <i>35 gpm</i> (HP) (yield/gpm)				
<i>Electric</i> (type power)				
(7) electric log <i>Yes</i> (yes or no)				
<i>Geo. Geological</i> (organization running log)				
(8) how well bottom plugged <i>Backwash</i> <i>Value</i>				
DRILLERS REMARKS:				

CODED

If well telescopes please sketch and show depths.

GROUND LEVEL

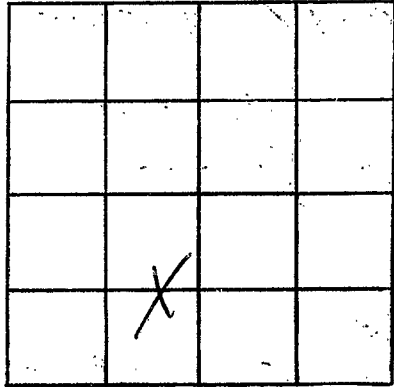

SECTION 35

Please indicate well location X.

ADDITIONAL INFORMATION

If more than one screen, show locations of each on sketch.