

ELOG # 347

MISSISSIPPI
BOARD OF WATER COMMISSIONERS
416 North State Street
Jackson, Mississippi 39201

WATER WELL DRILLERS LOG

CODED

RANKIN
F46
10-17-71

10117 19 71 Jack Quinn water Rankin county well located
date well completed firm name well ser.

LANDOWNER:
Lay m. Co. Co.
(mailing address)

WELL LOCATION:
sec 25 T. 60 N R. 20 E
10 miles N-E of Jackson
(distance) (direction) (nearest town)

WELL PURPOSE: Water
(home, irrigation, municipal, industrial)

- WELL COMPLETION DATA:
- (1) diameter (inches) 4 in
 - (2) total depth (feet) 735 ft
 - (3) static water level (feet) 160 (below top of ground)
 - (4) casing Black 700 ft.
(material) (depth)
4 in if telescope see back.
(size)
 - (5) screen 20 ft. 700 ft.
(length) (depth to top)
2 in Stainless Steel
(size) (material)
 - (6) pump 3/4 10 gal.
(HP) (yield gpm)
R. E. A.
(type power)
 - (7) electric log yes
(yes or no)
W. S. H. S.
(organization running log)

(8) how well bottom plugged Back
water valve

description of formations encountered	from	to
Brown clay	0	160
Blue clay	160	430
Sand	430	550
Clay	550	560
Sand & shell	560	735
Brown clay	0	160
Blue	160	430
Sand	430	550
Clay	550	560
Sand & shell	560	735

CODED

OCT 29 1971

MISS. RD. OR
WATER COM.

DRILLERS REMARKS:

If well telescopes please sketch and show depths.


GROUND LEVEL

317 ft. 4 in. ←

383 ft. 2 in. ←

20 ft. Screen

If more than one screen,
show locations of each on sketch.

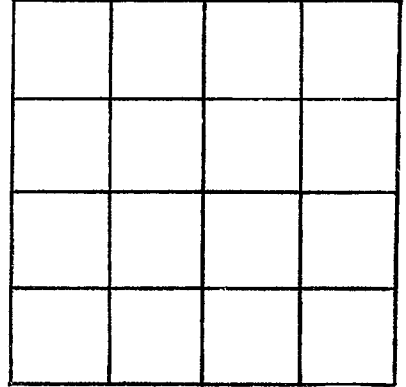

SECTION _____

Please indicate well location X.

ADDITIONAL INFORMATION

Lined area for additional information.