

**RANKIN**  
**F47**  
**1-17-72**

MISSISSIPPI  
 BOARD OF WATER COMMISSIONERS  
 416 North State Street  
 Jackson, Mississippi 39201

MAR 15 1972

WATER WELL DRILLERS LOG

**CODED**

1-17 1972 Forest Drilling Ser. firm name  
 date well completed county well located

LANDOWNER: Miss. Valley Tool Service  
P.O. Box 1019 Jackson Miss.  
 (mailing address)

description of formations encountered	from	to
Yellow clay	0	18
Sand	18	34
Brown clay	34	109
Soft clay + shale	109	137
Soft clay	137	212
Sand + clay	212	217
Hard clay	217	297
Soft clay + sh. silt	297	317
Sand + sh. shale	317	362
Soft clay	362	377
Hard clay	377	487
Rock	487	489
Hard clay	489	499
Rock	499	501
Hard clay + sh. Rock	501	517
Hard clay	517	537
Soft clay	537	617
Hard clay	617	637
Soft clay + sh. silt	637	657
Soft clay	657	717
Clay + sand	717	738
Clay	738	759
Fine sand + sh. clay	759	780
Fine sand	780	801
Fine sand + sh. clay	801	822
Shale	822	828
Shale + sh. silt	828	849

WELL LOCATION:  
 sec. 33 T. 6 N. R. 2 E  
2 miles N/E of Flowers  
 (distance) (direction) (nearest town)

WELL PURPOSE: Industrial  
 (home, irrigation, municipal, industrial)

- WELL COMPLETION DATA:
- (1) diameter (inches) 6" x 4"
  - (2) total depth (feet) 822'
  - (3) static water level (feet) 157' below top of ground.
  - (4) casing galv. 782'  
 (material) (depth)  
6" x 4" if telescope see back.  
 (size)
  - (5) screen 40' 822'  
 (length) (depth to top)  
3" Stainless Steel  
 (size) (material)
  - (6) pump 10 85 GPM  
 (HP) (yield gpm)  
Electric  
 (type power)
  - (7) electric log yes  
 (yes or no)  
Miss. Geological Survey  
 (organization running log)
  - (8) how well bottom plugged Backwash  
Value


**CODED**

DRILLERS REMARKS:

(X)

If well telescopes please sketch and show depths.

GROUND LEVEL

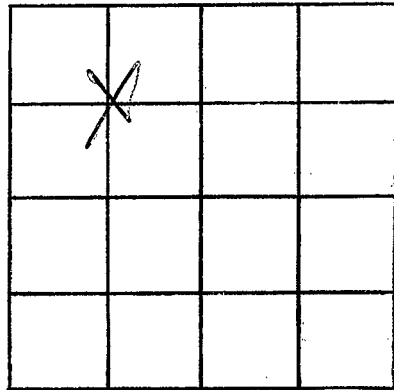

SECTION 3.3

Please indicate well location X.

ADDITIONAL INFORMATION

If more than one screen, show locations of each on sketch.