

RANKIN
F50
9-6-72


MISSISSIPPI
 BOARD OF WATER COMMISSIONERS
 416 North State Street
 Jackson, Mississippi 39201
WATER WELL DRILLERS LOG

9/6/72 19 F. L. James Const. Co. RANKIN
 date well completed firm name county well located

LANDOWNER:	description of formations encountered	from	to
State of Miss.	Clay	0	8
HWY. Dept.	Sand		77
(mailing address)	Blue Clay		102
WELL LOCATION:	Clay + 5ths Sand		122
sec. <u>23</u> T. <u>6</u> N. R. <u>2</u> E.	Blue Clay		110.3
<u>HWY-25</u> miles <u>E</u> of <u>JACKSON</u>	Clay + 5ths Sand		183
(distance) (direction) (nearest town)	Clay		204
WELL PURPOSE: <u>Road Bldg.</u>	Clay + Silt		265
(home, irrigation, municipal, industrial)	Clay		367
WELL COMPLETION DATA:	Soft Shale		457
(1) diameter (inches) <u>2 1/2"</u>	Soft Shale + Sand		491
(2) total depth (feet) <u>756'</u>	Clay + Sand		563
(3) static water level (feet) <u>170'</u> below top of ground.	Finest clay		585
(4) casing <u>steel, 726'</u> (material) (depth)	Clay		594
(size) if telescope see back.	Shale		613
(5) screen <u>30'</u> , <u>726'</u> (length) (depth to top)	Rock		616
<u>2 1/2"</u> , <u>Galv. Wire</u> (size) (material)	Shale		621
(6) pump <u>B4-OWNER-25</u> (HP) (yield gpm)	7 sand + 5ths clay		636
<u>Elect.</u> <u>25</u> (type power)	Clay + 5ths Sand		676
(7) electric log <u>NO</u> (yes or no)	7 sand + 5ths clay		692
(organization running log)	7 fine sand		696
(8) how well bottom plugged <u>2"</u>	7 sand + clay		704
<u>BACKWASH VALVE</u>	7 fine sand		756
DRILLERS REMARKS:			

If well telescopes please sketch and show depths.

GROUND LEVEL

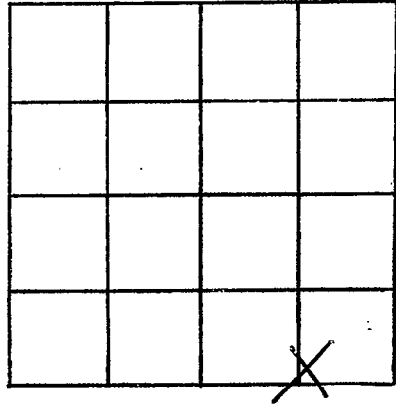

SECTION 23

Please indicate well location X.

ADDITIONAL INFORMATION

If more than one screen,
show locations of each on sketch.