

RANKIN
F 50
4-16-73

MISSISSIPPI
 BOARD OF WATER COMMISSIONERS
 416 North State Street
 Jackson, Mississippi 39201

CODED

WATER WELL DRILLERS LOG

2/16 1973 Forest Drilling Service Rankin
 date well completed firm name county well located


| LANDOWNER: | description of formations encountered | from | to |
|--|---------------------------------------|------|-----|
| Dean Cooper Rt 4 Jackson (mailing address) | Brown Clay | 0 | 40 |
| WELL LOCATION: sec <u>36</u> T <u>6</u> N R <u>2</u> E <u>4</u> miles <u>E</u> of <u>Howood</u> (distance) (direction) (nearest town) | Clay + Sand | 40 | 58 |
| WELL PURPOSE: (home, irrigation, municipal, industrial) | Blue Clay | 58 | 347 |
| WELL COMPLETION DATA: | Shale | 347 | 430 |
| (1) diameter (inches) <u>2"</u> | Sandy Shale | 430 | 450 |
| (2) total depth (feet) <u>651</u> | Soft shale | 450 | 492 |
| (3) static water level (feet) <u>170</u> below above top of ground. | Soft shale + silt | 492 | 573 |
| (4) casing <u>Galv</u> <u>651</u> , (material) (depth) <u>2"</u> If telescope see back. (size) | Soft shale | 573 | 533 |
| (5) screen <u>15'</u> (length) (depth to top) <u>#008-2" Stainless</u> (size) (material) | Soft Shale + fine sand | 533 | 581 |
| (6) pump <u>1/2</u> <u>20</u> (HP) (yield gpm) <u>Electric</u> (type power) | Fine sand | 581 | 653 |
| (7) electric log <u>No</u> (yes or no) | Clay + other fine sand | 653 | 663 |
| (8) how well bottom plugged <u>2" B.W. Valve</u> | | | |
| DRILLERS REMARKS: | | | |

CODED

MISSISSIPPI BOARD OF WATER COMMISSIONERS
 JACKSON, MISSISSIPPI 39201

If well telescopes please sketch and show depths.

GROUND LEVEL

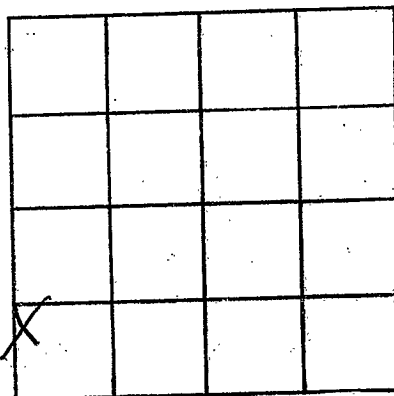

SECTION 36

Please indicate well location X.

ADDITIONAL INFORMATION

If more than one screen,
show locations of each on sketch.